



Doc ID: 007520020001 Type: GEN
Recorded: 12/23/2016 at 10:41:55 AM
Fee Amt: \$7.00 Page 1 of 1
Black Hawk County Iowa
SANDIE L. SMITH RECORDER

File 2017-00011698

* VJ Engineering
env

United States Public Land Survey Corner Certificate of

Land Survey Monuments situated in Section No. 10, Township No. 87 North,
Range No. 14 West, of the Fifth Principal Meridian, Black Hawk County, Iowa
Previously recorded in File No. 2014-04812.

Show reason for preparing this certificate, the evidence and detailed procedures used in establishing the corner positions and monumentation found or placed.)

Monument Description and Remarks: South 1/4 Corner, Section 10-T87N-R14W



Black Hawk County WPA Field Notes dated Sept. 7th, 1938 state "N 1/4 Cor. Sec. 15-87-14 found frost broken limestone 6"x10"x15", lowered stone and set C.M. on top 12" underground. Searched area and found called for Concrete Monument with Brass Cap. Set 12" Spike on the North side for magnetic detection.

This corner certificate is being prepared to update the reference ties.

Corner was used for a survey in the NE 1/4 of Section 10-T87N-R14W.

PLAN - VIEW

(Show a minimum of three reference ties to durable physical objects, relevant monuments and physical conditions that will enable recovery of the corner.)

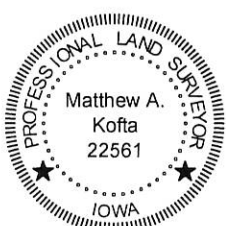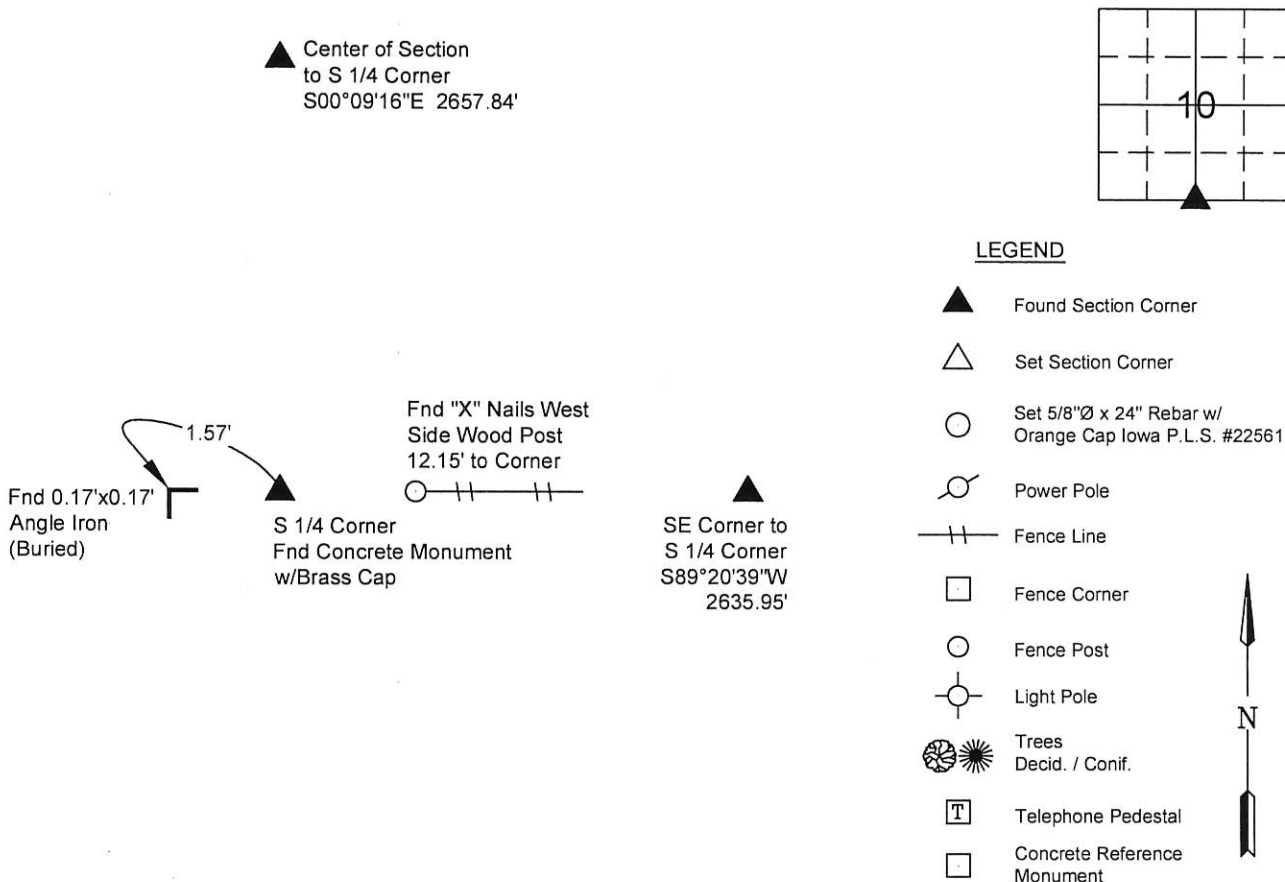

I hereby certify that this land surveying document was prepared and the related survey work was performed by me or under my direct personal supervision and that I am a duly licensed Land Surveyor under the laws of the State of Iowa.

Matthew A. Kofa 12-20-16
Matthew A. Kofa, P.L.S. Date

License Number 22561

My license renewal date is December 31, 2018

Pages or sheets covered by this seal: 1

List Corner to be Indexed

Corner	Section	Twp	Range
South 1/4	10	87 North	14 West



VJ Engineering
1501 Technology Parkway
Cedar Falls, Iowa - 319-266-5829

Section Corner
Reference Ties

file no.
168086

drawn by
MAK

date
12/20/16