

SC Misc
COMPARE

BLACK HAWK COUNTY IOWA: SS 16446
Filed for record Mar 14, 1996 at 11:55 A.M. and recorded in Book 319 of Misc Page 883.
Recorder
Fee 1-5.00/

County Assessor

Paul H. Helland 2322 W 1ST ST SUITE B CEDAR FALLS, IOWA 50613 (319) 266-0161

UNITED STATES PUBLIC LAND SURVEY CORNER CERTIFICATE
OF


Land Survey Monuments situated in Section 12, Township 87, Range 14, of the Fifth Principal Meridian, BLACK HAWK County, Iowa.
Previously recorded in Book _____, Page _____.

(Show reason for preparing this certificate, the evidence and detailed procedures used in establishing the corner positions and monumentation found or placed.)

Monument Description and Remarks: SURVEY DONE IN E 1/2 SEC 14/
SEC. 1-87-14
N 1/4 (OR SEC. 12-87-14) FOUND NAIL
W/FLAGGING SET PIN (1/2" REBAR W/CAP NO. 6505)

PLAN - VIEW

(Show a minimum of three reference ties to durable physical objects, relevant monuments and physical conditions that will enable recovery of the corner.)

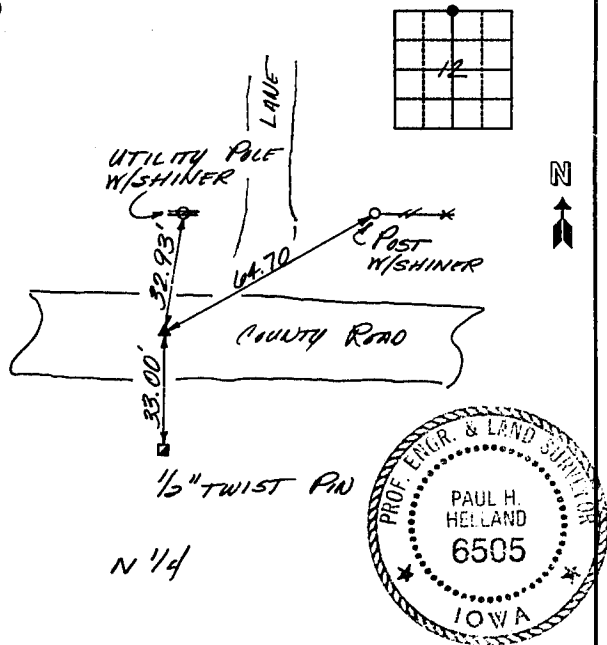

I hereby certify that this plat, map, survey or report was made by me or under my direct personal supervision and that I am a duly Registered Land Surveyor under the laws of the State of Iowa.
PAUL H. HELLAND, P. E. & L. S. IOWA REGISTRATION NO. 6505
My registration expires December 31, 1998

List Corners to be Indexed			
Corners	Section	Twp	Range
N 1/4	12	87	14

HELLAND ENGINEERING & SURVEYING, LTD.
Thunder Ridge Bank Building
2322 West First St., Suite B
Cedar Falls, Iowa 50613
319-266-0161