

BLACK HAWK COUNTY ENGINEER

Document Number: 2007005770

Date: Sep 07, 2006 4:30:00 pm

Aud Fee: 0.00 Rec Fee: 0.00

Trans Tax: 0.00 Rec Management Fee: 0.00

E-Com Fee: 0.00 Non-Standard Page Fee: 0.00

Filed for record in Black Hawk County, Iowa  
Patricia S. Sass, County Recorder

PREPARED BY: BLACK HAWK COUNTY ENGINEERS OFFICE  
316 E. FIFTH STREET, ROOM 211 WATERLOO, IOWA 50703

PH.# (319) 833-3008  
FAX.# (319) 833-3139

SLSI 9-94  
CERT 12-98

UNITED STATES PUBLIC LAND SURVEY CORNER CERTIFICATE OF  
Land Survey Monuments situated in Section 13, Township 87,  
Range 14, of the Fifth Principal Meridian, BLACK HAWK County, Iowa.  
Previously recorded in Misc. Book n/a, Page n/a, in County Recorder's Office.

(Show reason for preparing this certificate, the evidence and detailed procedures used in establishing the corner positions and monumentation found or placed.)

Monument Description and Remarks: FND. #5 RBR. LOCATED 2" DEEP @ ± CENTER  
OF INTERSECTION AND TIED AS SHOWN. NO PUBLIC COR. CERT. ON RECORD, TO DATE.  
RECORD PLAT OF SURVEY TO N.W. REF.'S CORNER, PER CO. RECORDER MISC. BK. 285 p. 693.  
CORNER UTILIZED FOR R.O.W. ACQUISITION AND GEOM. REF. FOR NEW BR. REPL. PROJECT  
DIRECTLY NORTH, 2006.


### PLAN - VIEW

(Show a minimum of three reference ties to durable physical objects, relevant monuments and physical conditions that will enable recovery of the corner.)


NOT TO SCALE

#### NOTES:

- 1.) TIE DIST. MEAS. PLUMB (H.D.)
- 2.) "S.M." DENOTES "SURVEY MARKER"
- 3.) (P.) DENOTES "PLATTED" DIMENSION  
(M.) DENOTES "MEASURED" DIMENSION

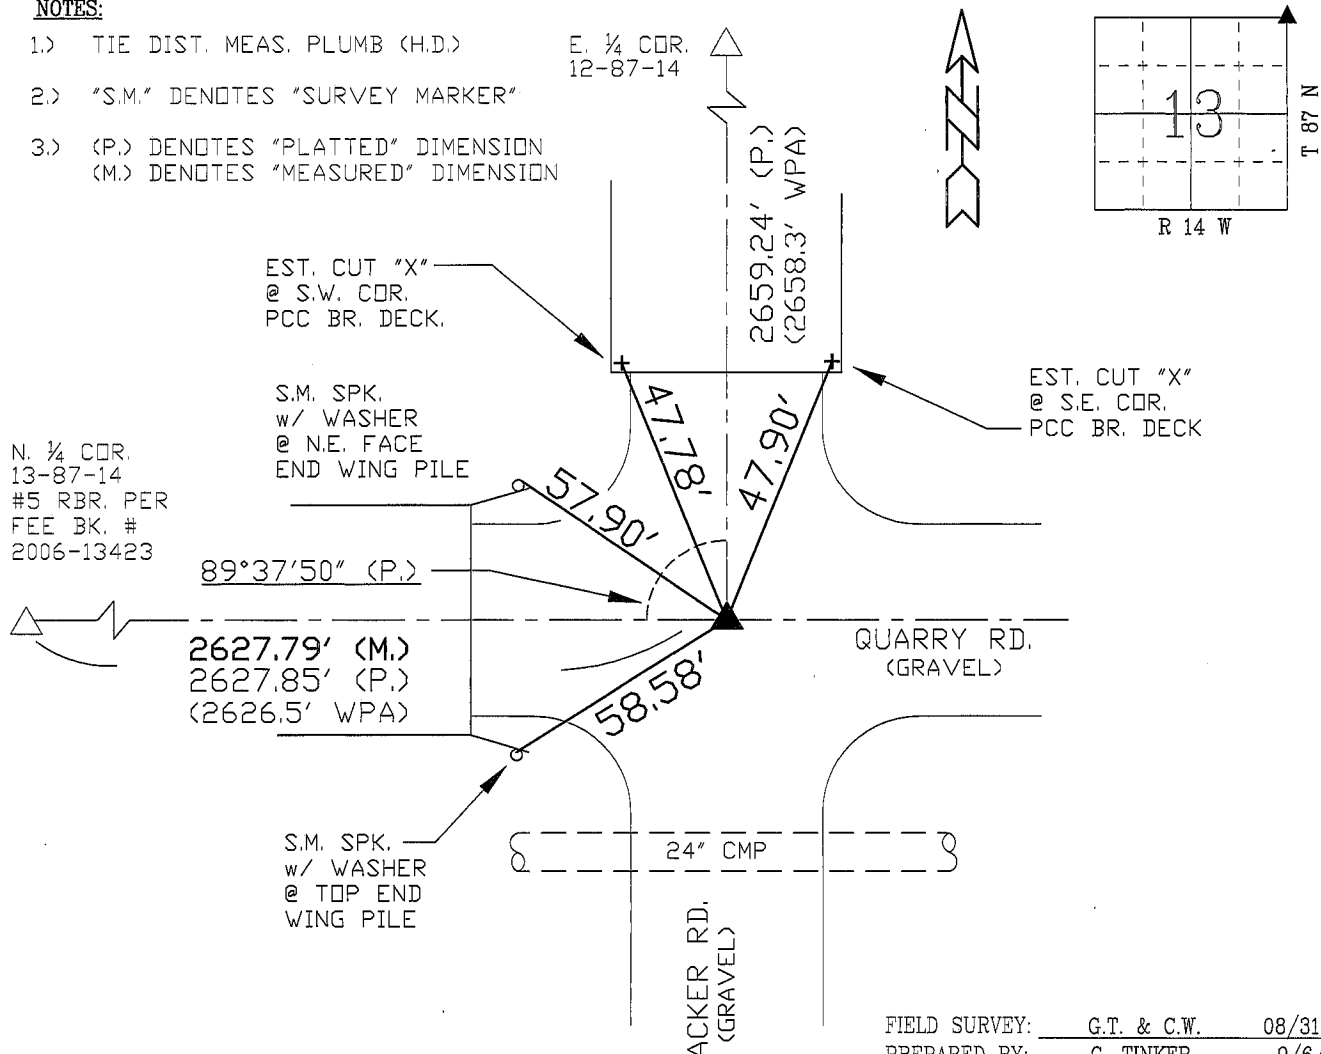

### CERTIFICATION

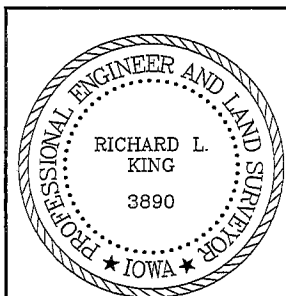

I hereby certify that this land surveying document was prepared and the related survey work was performed by me or under my direct personal supervision and that I am a duly licensed Land Surveyor under the laws of the State of Iowa.

*Richard L. King*  
Richard L. King (date)

License Number 3890

My license renewal date is December 31, 2007

Pages or sheets covered by this seal:

This Land Corner Certificate Only.

### LIST CORNERS TO BE INDEXED

Corner	Section	Township	Range
N.E. COR.	13	87	14
S.E. COR.	12	87	14
N.W. COR.	18	87	13
S.W. COR.	07	87	13