INDEX FEE BOOK # 2006 BLACK HAWK COUNTY, IOWA:ss


PROOF 2005, AT_ <u>4:00 Р</u>м. FEE <u>1-5.00/</u>-1.00/ SEP 27 FILED FOR RECORD _

8372

COMPARED BLACK HAWK COUNTY RECORDER

HELLAND ENGINEERING & SURVEYING

Jeffrey P. Helland, 1107 Technology Parkway, Cedar Falls, Iowa 50613-6951, (319)-266-0161

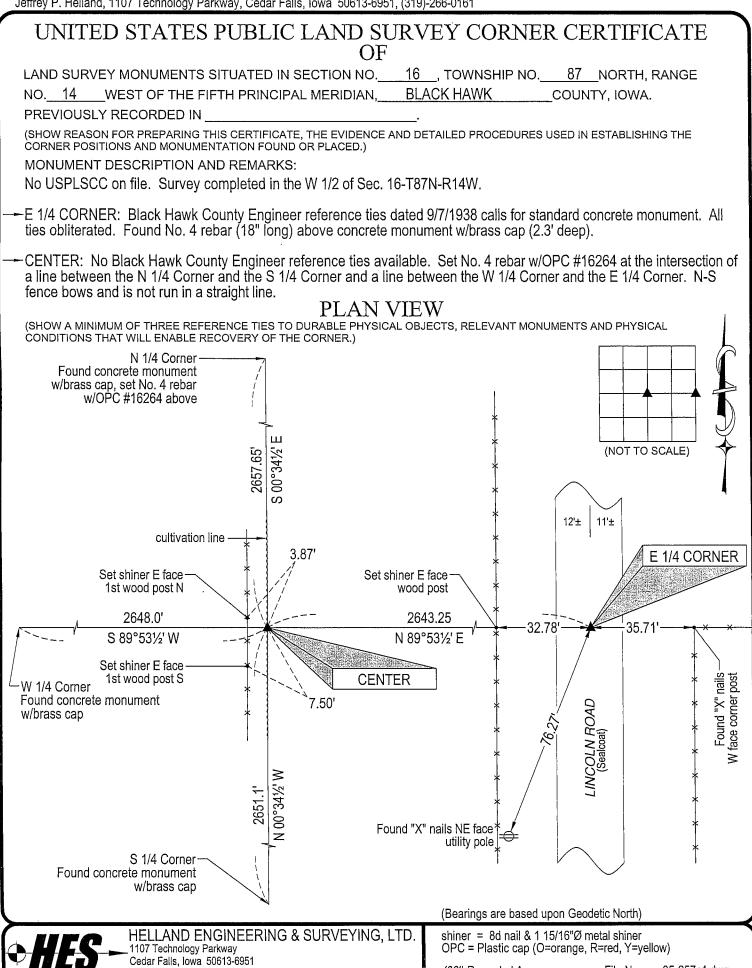

I hereby certify that this land surveying document was prepared and the related survey work was performed by me or under my direct personal supervision and that I am a duly licensed Land Surveyor under the laws of the State of Iowa. SECTION TOWNSHIP RANGE CORNER 14W E 1/4 CORNER 16 87N ellanel HELLAND 16264 Jeffrey P Helland License Number 16264 14W 87N CENTER 16 My license renewal date is December 31, 2005. All pages or sheets are covered by this seal except: AWO\

(00') Recorded As

(319)-266-0161

LAND

File Name: 05-257c4.dwg

LIST CORNERS TO BE INDEXED