Number: 202300000370

Recorded: 7/8/2022 at 9:22:51.0 AM

County Recording Fee: \$7.00 Iowa E-Filing Fee: \$3.00 Combined Fee: \$10.00

Revenue Tax:

Sandie L. Smith, RECORDER Black Hawk County, Iowa

Prepared by & Return to: Herold - Reicks Surveying, 2206 East Bremer Avenue, Waverly, IA 50677, Ph. 319-483-5187

United States Public Land Survey Corner Certificate

Land Survey Monument situated in

Section 19, Township 87 North, Range 14 West of the Fifth Principal Meridian, Black Hawk County, Iowa. Not on file in the County Recorder's Office.

This certificate is being prepared in compliance with Iowa Code Chapter 355.11 because:


X	There is no certificate on file for this corner.
	There are no longer three valid ties of record.
	There are changes to reference ties of record.
	There is change of monumentation of record.
	To clarify description of record monument (ties).


Monument Description and Remarks:

Northeast Corner: Found 2" Pinched Pipe with information obtained from Cornerstone Ties Field Book 1010, Page 60, of T87N R14W, on file in the County Engineer's Office.

Plan View

(Show a minimum of three reference ties to durable physical objects, relevant monuments and physical conditions that will enable recovery of the corner.)

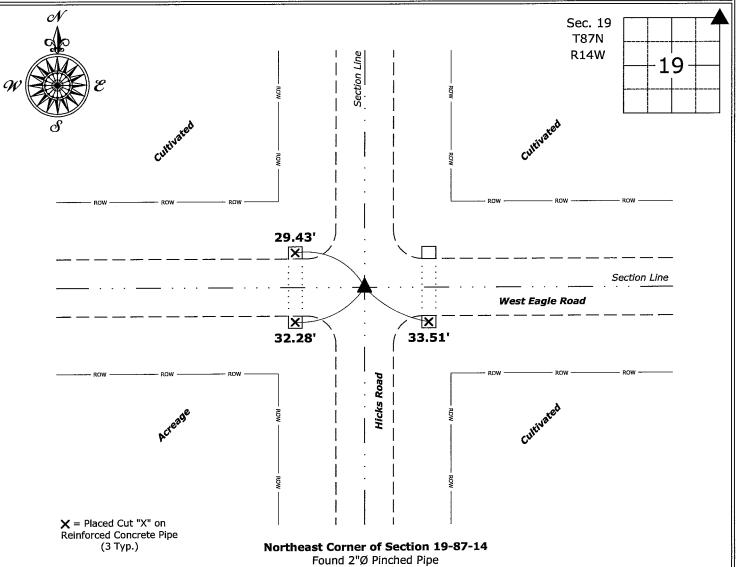

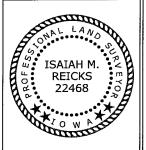

I hereby certify that this land surveying document was prepared and the related survey work was performed by me or under my direct personal supervision and that I am a duly licensed Land Surveyor under the laws of the State of Iowa.

7-7-22 Isaiah M. Reicks Date:

License number 22468

My license renewal date is December 31, 2023. Sheets covered by this seal: Individual sheet only

List Corner to be Indexed				
Corner	Section	Twp.	Range	
NE	19	87	14	

Project Number: 2022-521 FB: Black Hawk 1, Pgs. 38-41 Projects - WO\County Control Systems_WO\BLACK HAWK\BHCO-32\BHCO-32.dwg, 7/7/2022 4:18:48 PM