

Number: 202300000371  
Recorded: 7/8/2022 at 9:22:51.0 AM  
County Recording Fee: \$7.00  
Iowa E-Filing Fee: \$3.00  
Combined Fee: \$10.00  
Revenue Tax:  
Sandie L. Smith, RECORDER  
Black Hawk County, Iowa

Prepared by & Return to: Herold - Reicks Surveying, 2206 East Bremer Avenue, Waverly, IA 50677, Ph. 319-483-5187

United States Public Land Survey Corner Certificate

Land Survey Monument situated in  
Section 19, Township 87 North, Range 14 West of the Fifth Principal Meridian, Black Hawk County, Iowa.  
Not on file in the County Recorder's Office.

This certificate is being prepared in compliance  
with Iowa Code Chapter 355.11 because:

- 
- ☒

 There is no certificate on file for this corner.  

☐

 There are no longer three valid ties of record.  

☐

 There are changes to reference ties of record.  

☐

 There is change of monumentation of record.  

☐

 To clarify description of record monument (ties).


Monument Description and Remarks:

**Southeast Corner of the Fr'1 SW 1/4 - Fr'1 SW 1/4:** Set 1"Ø Bronze Survey Marker on line between the Southeast and South Quarter Corners of said Section at the proportionate record distance, as shown in the Original GLO Plat of said Township.

An extensive search of all of the records within the County offices was performed as part of the section corner recovery. There were no records located of the perpetuation of a monument at this corner.

Plan View

(Show a minimum of three reference ties to durable physical objects, relevant monuments and physical conditions that will enable recovery of the corner.)

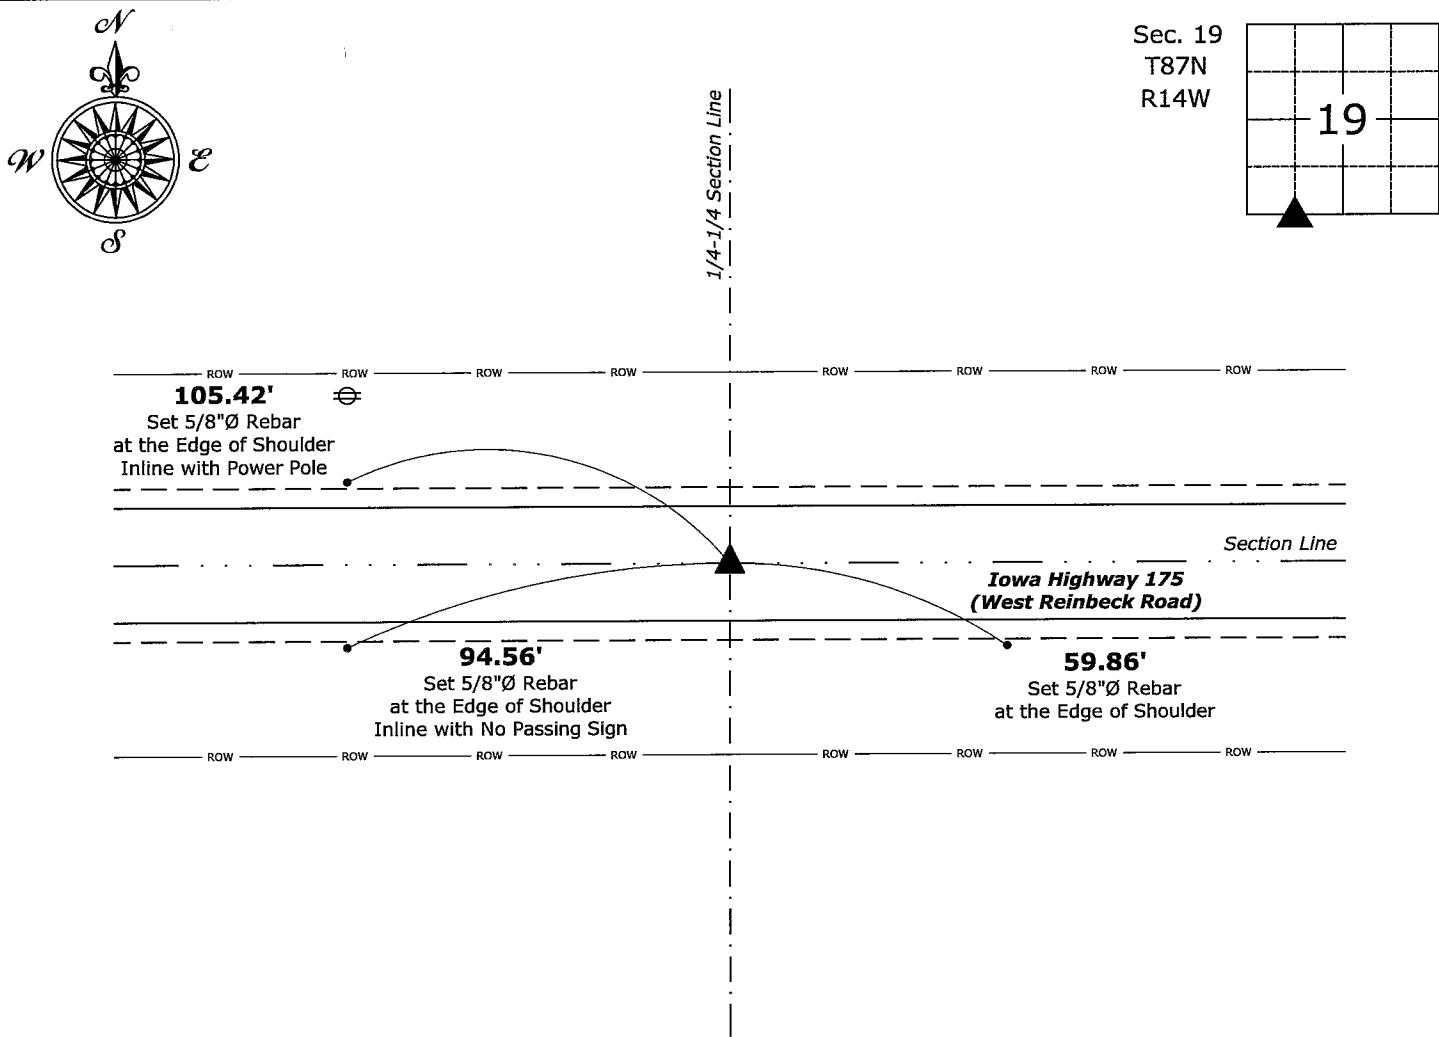

**Southeast Corner of the Fr'1 SW 1/4 - Fr'1 SW 1/4 of Section 19-87-14**  
Set 1"Ø Bronze Survey Marker PLS 22468



I hereby certify that this land surveying document was prepared and the related survey work was performed by me or under my direct personal supervision and that I am a duly licensed Land Surveyor under the laws of the State of Iowa.  
*Isaiah M. Reicks* 7-7-22  
Isaiah M. Reicks Date:  
License number 22468  
My license renewal date is December 31, 2023.  
Sheets covered by this seal: Individual sheet only

List Corner to be Indexed			
Corner	Section	Twp.	Range
SE-SW-SW	19	87	14
Project Number: 2022-521			
FB: Black Hawk 1, Pgs. 38-41			