

SC ✓
Misc ✓
INDEX ✓
MARGIN ✓
PROOF ✓
COMPARE ✓

BLACK HAWK COUNTY IOWA:SS
Filed for record Nov 16, 1998 at
4:00 P.M. and recorded in Book 332
of Misc Page 305

11605

Richard L. King Recorder
BLACK HAWK COUNTY ENGINEER

PREPARED BY: BLACK HAWK COUNTY ENGINEERS OFFICE
316 E. FIFTH STREET, ROOM 211 WATERLOO, IOWA 50703

PH# (319) 291-2419
FAX# (319) 291-2461
SLSI 9-94
CERT 12-98

UNITED STATES PUBLIC LAND SURVEY CORNER CERTIFICATE OF
Land Survey Monuments situated in Section 21, Township 87 N,
Range 14 W, of the Fifth Principal Meridian, BLACK HAWK County, Iowa.
Previously recorded in Misc. Book N/A, Page N/A, in County Recorder's Office.

(Show reason for preparing this certificate, the evidence and detailed procedures used in establishing the corner positions and monumentation found or placed.)



Monument Description and Remarks: CENTER 21-87-14: FOUND 5/8" RBR.
PER ONLY REM. COUNTY TIE. EST. 2" ALUM. CAP STAMPED "B.H. CO. LAND
CORNER". MON. LOCATED 8' DEEP 18.5' S. OF S. EDGE ACC ROADWAY.
S.E. CORNER S.W. 1/4, N.E. 1/4 SECT. 87-87-14: FOUND 1/2" REBAR WITH
ORANGE L.S. CAP #6505. NO RECORD TIES AVAIL. EST. REF. MON.'S AND
TIED AS SHOWN. CORNER'S UTILIZED FOR ROAD VACATION IN VOORHIES.

PLAN - VIEW

(Show a minimum of three reference ties to durable physical objects, relevant monuments and physical conditions that will enable recovery of the corner.)

NOTE: ALL DISTANCES PLUMB


NOT TO SCALE

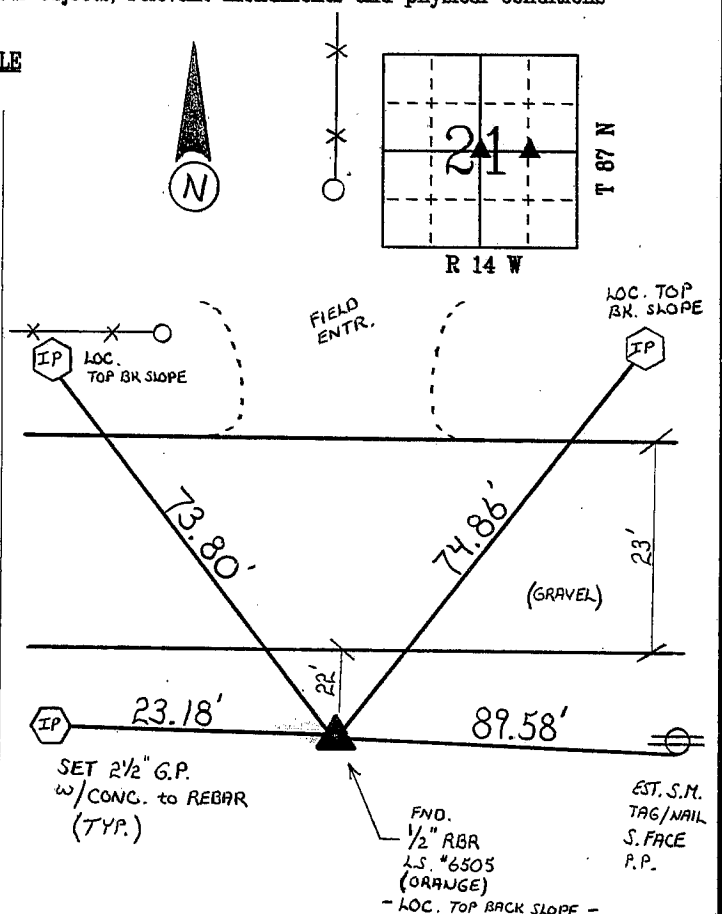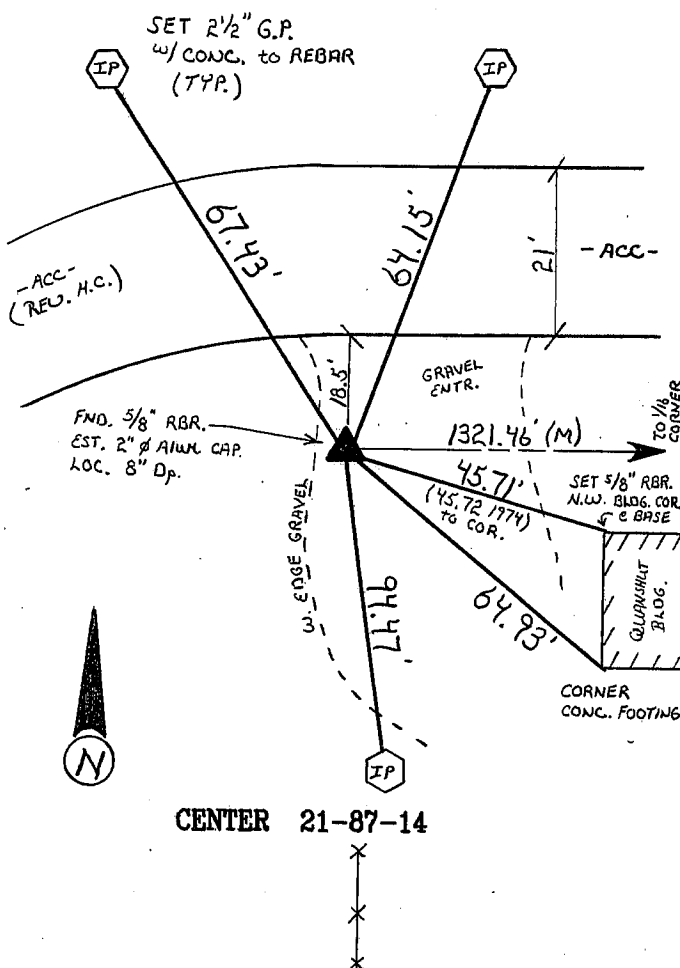

S.E. COR., SW1/4, NE1/4
SECT. 21-87-14

FIELD SURVEY: G.T., B.K., C.W. 10/05/98
PREPARED BY: G.T. 10/29/98

CERTIFICATION

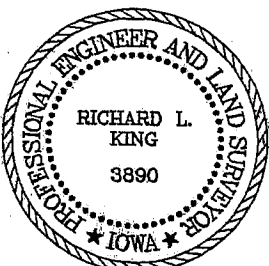

I hereby certify that this land surveying document was prepared and the related survey work was performed by me or under my direct personal supervision and that I am a duly licensed Land Surveyor under the laws of the State of Iowa.

Richard L. King 11/16/98
Richard L. King (date)

License Number 3890

My license renewal date is December 31, 1999

Pages or sheets covered by this seal:

This Land Corner Certificate Only.

LIST CORNERS TO BE INDEXED

Corner	Section	Township	Range
CENTER	21	87 N	14 W
S.E. COR. S.W. 1/4, N.E. 1/4	21	87 N	14 W