

PREPARED BY: ~~BLACK HAWK COUNTY ENGINEERS OFFICE~~
316 E. FIFTH STREET, ROOM 211 WATERLOO, IOWA 50703

PH.# (319) 833-3008
FAX.# (319) 833-3139

SLSI 9-94
BHCO 03-09

UNITED STATES PUBLIC LAND SURVEY CORNER CERTIFICATE OF
Land Survey Monuments situated in Section 22, Township 87 N,
Range 14 W, of the Fifth Principal Meridian, BLACK HAWK County, Iowa.
Previously recorded in Misc Book N/A, Page N/A, in County Recorder's Office.
(Show reason for preparing this certificate): There is No Certificate for the corner on file with County Recorder, per
Ia. Code 355.11(1)(a).

(Evidence and detailed procedures used in establishing the corner position(s) and monumentation found or placed.)

Monument Description and Remarks: N 1/4 CORNER:
CORNER RESET FOR COLD-IN-PLACE RECYCLE & H.M.A. RESURF. PROJECT LFM-503--7X-07.
PRIOR TO RESURF. PROJECT, FOUND 3/8" STEEL PIN AND TEMP. REF. CORNER LOC. PER RTK
GPS. AFTER 4" DEEP MILL & RECYCLE COURSE, NO SOUNDING REMAINED & NO EXCAVATION
DONE @ LOCATION. AFTER +3" H.M.A. RESURF. COURSE, RESET CORNER WITH 5/8" (#5) x
8'L. REBAR LOCATED @ ±3" NORTH OF H.M.A. JOINT AND ALIGNED WITH FENCE LINE TO
NORTH.

PLAN VIEW


"NOT TO SCALE"

BHco Hist. Ties: BK. #1000 p. 22 T87-R14

FIELD BOOK: Ties per Topcon 7003i #Z0115

(Show a minimum of three reference ties to durable physical objects, relevant monuments and physical conditions
that will enable recovery of the corner.)

- 1.) TIES PER EDM MEASURE IN EITHER PRISM
"OR" NON-PRISM MODE, WHILE UTILIZING
"INDIRECT" MEASURE, WITH ALL DISTANCES
PLUMB/HORIZ. (HD), UNLESS DENOTED.
- 2.) SECTION LINE MEASURE REFERS TO "LOCAL
GROUND" DIST. AND INCLUDES ELLIPSOID
(COMBINED) SCALE FACTOR FROM S.P.C.
GRID INVERSE (AS OBSERVED), PER AVG.
SCALE FACTOR = 1.000080238400 @ GPS
Mon. #19.

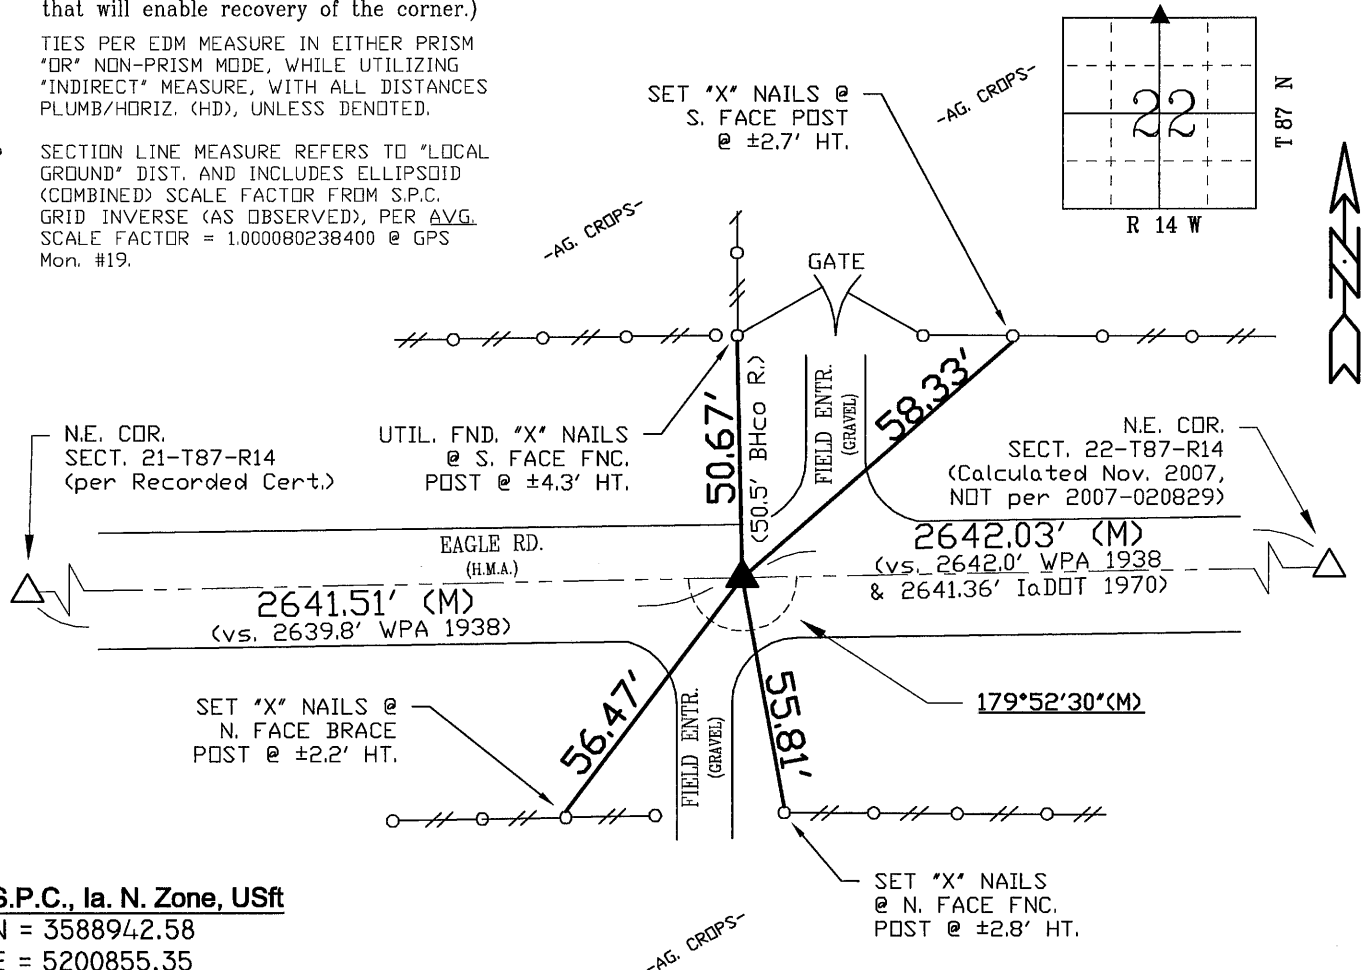

S.P.C., Ia. N. Zone, USft

N = 3588942.58

E = 5200855.35

CONVERGENCE = 0° 42' 03"

(NAD83-NSRS2007 "BHco07", RTK OBS.)

FIELD SURVEY: S.S. & V.S. 6/27/12

PREPARED BY: S.S. & G.T. 11/26/12

CERTIFICATION



I hereby certify that this land surveying document
was prepared and the related survey work was
performed by me or under my direct personal
supervision and that I am a duly licensed Land
Surveyor under the laws of the State of Iowa.

Geoffrey Allen Tinker 12/04/2012
Geoffrey Allen Tinker (date)

License Number 15748

My license renewal date is December 31, 2012

Pages or sheets covered by this seal:

This Land Corner Certificate Only.

LIST CORNERS TO BE INDEXED

Corner	Section -	Township -	Range
N. 1/4 Cor.	22	87 N	14 W
S. 1/4 Cor.	15	87 N	14 W

INDEX OF ABBREVIATIONS

(M) = "Measured" Dimension "NP" = Reflectorless EDM Meas.
(P) = "Platted" Dimension "MLM" = Indirect Measure
(R) = "Record" Dimension "CM" = Concrete Monument
(C) = "Calculated" Dimension "SM" = Survey Marker Spike/Tag
"IGS" = Iowa Geodetic Survey "PK" = PK/MAG Nail Brand Style
"WPA" = Works Progress Admin. Survey
"G" = per George Miller Survey (BHco Surveyor 1858-1860)
"B" = per John Ball Survey (BHco Surveyor 1866-1891)
"N" = per Nathan Barber Survey (BHco Surveyor 1908-1931)