MISC INDEXMAG MARGIN PROOF COMPARE BLACK HAWK COUNTY IOWA:SS 12308;
FILED FOR RECORD_DEC 3 , 1999 AT
3:00 P. M. AND RECORDED IN BOOK 336
OF MISC PAGE 555.

RECORDER
FEE 1-5:00X
HELLAND ENGINEERING & SURVEYING

Paul H. Helland, 1107 Technology Parkway, Cedar Falls, Iowa 50613-6951, (319)-266-0161

UNITED STATES PUBLIC LAND SURVEY CORNER CERTIFICATE OF

LAND SURVEY MONUMENTS SITUATED IN SECTION NO. 26 , TOWNSHIP NO. 87 NORTH, RANGE NO. 14 WEST OF THE FIFTH PRINCIPAL MERIDIAN, BLACK HAWK COUNTY, IOWA.

PREVIOUSLY RECORDED IN BOOK _____, PAGE

(SHOW REASON FOR PREPARING THIS CERTIFICATE, THE EVIDENCE AND DETAILED PROCEDURES USED IN ESTABLISHING THE CORNER POSITIONS AND MONUMENTATION FOUND OR PLACED.)


MONUMENT DESCRIPTION AND REMARKS:

SURVEY DONE IN NW 1/4 OF SEC. 26-T87N-R14W.

NW CORNER: No County or State ties. Road Surface overlayed within last 2 years. Corner not reestablished after overlay. Reestablished corner from monumentation and right-of-way rails. Set Mag Nail in A.C.C. pavement, @ centerline of lowa Hwy. #175 and 32.9' West of centerline of U.S. Hwy #63.

PLAN VIEW

(SHOW A MINIMUM OF THREE REFERENCE TIES TO DURABLE PHYSICAL OBJECTS, RELEVANT MONUMENTS AND PHYSICAL CONDITIONS THAT WILL ENABLE RECOVERY OF THE CORNER.)

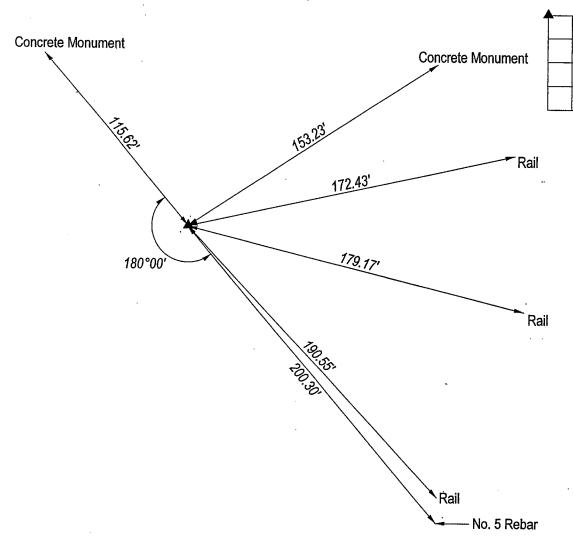

HES:

PAUL H. HELLAND

6505

/OWA

HELLAND ENGINEERING & SURVEYING, LTD. 1107 Technology Parkway

1107 Technology Parkway Cedar Falls, Iowa 50613-6951

(319)-266-0161

I hereby certify that this land surveying document was prepared and the related survey work was performed by me or under my direct personal supervision and that I am a duly licensed Land Surveyor under the laws of the State of Love

Surveyor under the laws of the State of Iowa.

Paul H. Helland

License Number 6505 My license renewal date is Dece

My license renewal date is December 31, 1999. All pages or sheets are covered by this seal except: FILE NAME: 99-273CC.DRG

26

LIST CORNERS TO BE INDEXED CORNER SECTION TOWNSHIP RANGE

NW CORNER 26

87N

14W