

SC
Misc
INDEX
MARGIN
PROOF
COMPARE

BLACK HAWK COUNTY IOWA.33
Filed for record DEC 29, 1998, at 15300
4:00 P.M. and recorded in Book 332
of Misc Page 933.
Recorder
Fee 1-5.00/
STEWART SURVEYING
504 TERRY TERRACE
MARSHALLTOWN IA 50158

Howard R. Stewart, 504 Terry Terrace, Marshalltown, Iowa 50158

(515) 752 - 2590

SLSI 9-94

UNITED STATES PUBLIC LAND SURVEY CORNER CERTIFICATE

Land Survey Monuments situated in Section 26, Township 87 NORTH, Range 14 WEST, of the Fifth Principal Meridian, BLACK HAWK County, Iowa.
Previously recorded in _____ in County Recorder's Office.

(book, page, document number, etc.)

(Show reason for preparing this certificate, the evidence and detailed procedures used in establishing the corner positions and monumentation found or placed.)

Monument Description and Remarks: CORNERS USED IN SURVEY IN NW 1/4 NE 1/4

S 1/4 COR - FOUND 1/2" IRON PIN IN PCC PVMT UNDER 3" ASPH. OVERLAY WITH ASSISTANCE OF

BLACKHAWK CO. SURVEY CREW FROM INFORMATION IN CO. ENG. OFFICE.

E 1/4 COR - FOUND 5/8" REBAR WITH 1/2" REBAR W/FLAGGING ON EAST SIDE OF 5/8" REBAR, 7" DEEP, WITH



ASSISTANCE OF BLACKHAWK CO. SURVEY CREW AND INFORMATION IN CO. ENG. OFFICE.

98193

PLAN - VIEW


(Show a minimum of three reference ties to durable physical objects, relevant monuments and physical conditions that will enable recovery of the corner.)

S 1/4 Cor. Sec. 26-87-14

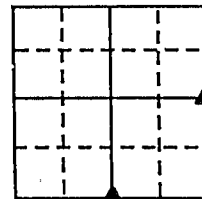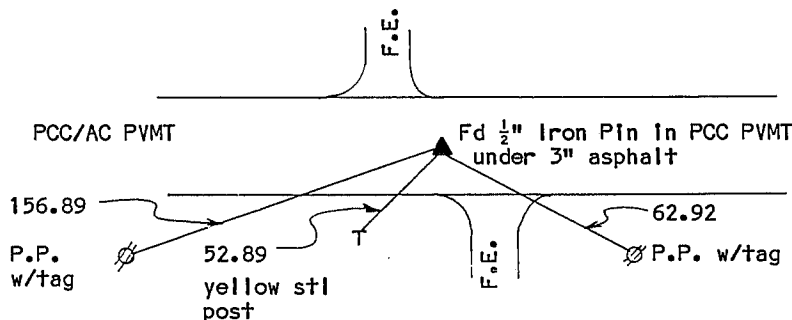

SEC. 26-87-14

E 1/4 Cor. Sec. 26-87-14

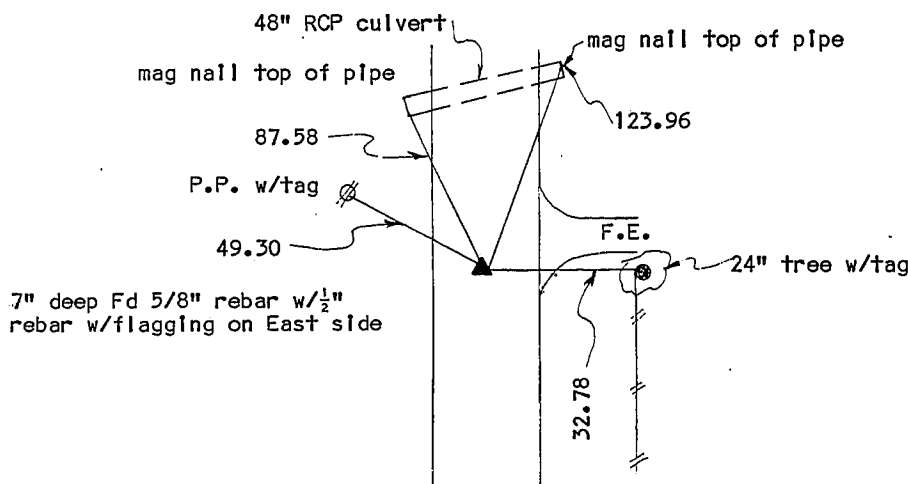

Ref. Updated
Ties 4/8/94
COR., PLS 10793
dtd. June 10,
2002

A. T.

I hereby certify that this land surveying document was prepared and the related survey work was performed by me or under my direct personal supervision and that I am a duly licensed Land Surveyor under the laws of the State of Iowa.

Signature: HOWARD R. STEWART


Name typed or printed: HOWARD R. STEWART

Date: DEC. 28, 1998 Reg. No. 9763

My License Renewal Is December 31, 19 98.

Corners	Section	Twp	Range
S 1/4 Cor.	26	87	14
E 1/4 Cor.	26	87	14

SEAL

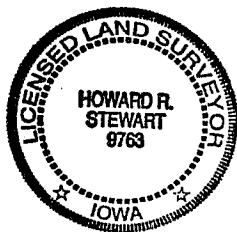

BOOK 332 PAGE 933