
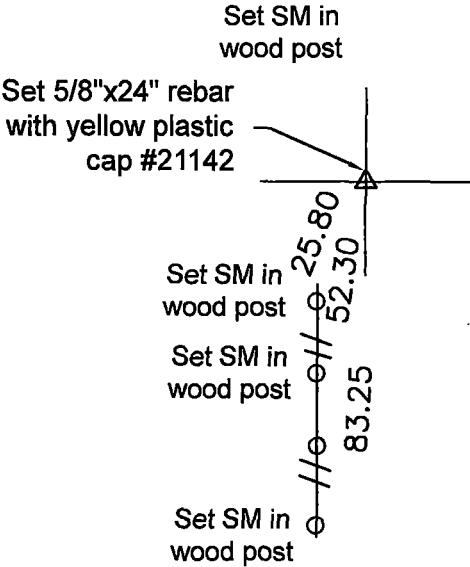
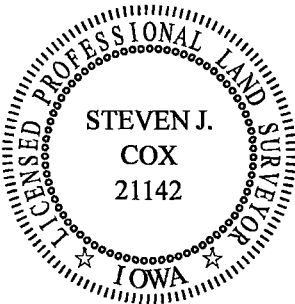


| | | | | | | | | | |
|---|---|--|---------|------|-------|--------|----|-----|-----|
| <div>UNITED STATES PUBLIC LAND SURVEY CORNER CERTIFICATE</div> <div>LAND SURVEYOR: (Return this document to the land surveyor after recording) Steven J. Cox, P.L.S., 303 Colfax St, Holland, Iowa 50642 Phone: 319-824-5129 email: sjc1989@yahoo.com</div> <div>Land Survey Monuments in Section <u>28</u>, Township <u>87</u> N, Range <u>14</u> W, of the 5th P.M., <u>Black Hawk</u> County, Iowa. Previously recorded in <u>NA</u> _____ in the County Recorder's Office. The monument(s) were used in a land survey for <u>Michael Fogt & Randall Fogt</u></div> | | <div> Doc ID: 012079910001 Type: GEN Recorded: 03/06/2024 at 11:14:42 AM Fee Amt: \$7.00 Page 1 of 1 Black Hawk County Iowa SANDIE L. SMITH RECORDER File 2024-00010808</div> | | | | | | | |
| <div>Monument, Description, and Remarks: Center: Set 5/8"x24 rebar with yellow plastic cap #21142 at the intersection of the north-south centerline of section and the east-west centerline of section +/-6.0 feet east of remaining north-south fence evidence. No previous corner certificate.</div> | | | | | | | | | |
| <div>ALL DIMENSIONS IN FEET UNLESS OTHERWISE NOTED-NOT TO SCALE</div> <div></div> | | | | | | | | | |
| <div></div> | <div>I hereby certify that this land surveying document was prepared and the related survey work was performed by me or under my direct personal supervision and that I am a duly licensed Professional Land Surveyor under the laws of the State of Iowa. Signature: <u>Steven J. Cox</u> Date: <u>3/5/24</u> Steven J. Cox, License No. 21142 My license renewal date is December 31, 2025 Pages or sheets covered by this seal: <u>1</u></div> | | | | | | | | |
| <div>List Corners to be Indexed</div> <table><tr><td>Corners</td><td>Section</td><td>Twp.</td><td>Range</td></tr><tr><td>Center</td><td>28</td><td>87N</td><td>14W</td></tr></table> | | Corners | Section | Twp. | Range | Center | 28 | 87N | 14W |
| Corners | Section | Twp. | Range | | | | | | |
| Center | 28 | 87N | 14W | | | | | | |