

File **2009-00019922**

PH.# (319) 833-3008
FAX.# (319) 833-3139

SLSI 9-94
CERT 03-09

Land Survey Monuments situated in Section 35 , Township 87 N ,
Range 14 W , of the Fifth Principal Meridian, BLACK HAWK County, Iowa.
Previously recorded in FEE. Book 2002, Page 33880, in County Recorder's Office.

(Show reason for preparing this certificate): The corner monument has been Replaced or Modified, per Ia. Code 355.11(1)(c)

(Evidence and detailed procedures used in establishing the corner position(s) and monumentation found or placed.)

Monument Description and Remarks: N.E. COR. FOUND 3/8" STEEL PIN. (ROUND HEAD IN LEAD PLUG WITHIN PCC PVM'T. PRIOR TO RUBBLIZATION. TEMP. REFERENCED CORNER TO TEMP. CONSTRUCTION TIES AND PERM. TIES, AS SHOWN. HMA RESURFACING @ 7" DEEP & 22' WIDE. CORNER RESET WITH ±7"L. x 5/8" REBAR FLUSH WITH HMA PAVEMENT, AND LOCATED @ ± C.L. HMA PAVING JOINT @ INTERSECTION WITH HOLMES RD. N./S.


PLAN — VIEW
"NOT TO SCALE"

BHco Hist. Ties: BK. #1000 (35) 87-14

FIELD BOOK: BHco. #488 p.13

(Show a minimum of three reference ties to durable physical objects, relevant monuments and physical conditions that will enable recovery of the corner.)

- 1.) TIES PER EDM MEASURE NON-PRISM
MODE, WHILE UTILIZING "INDIRECT"
MEASURE,

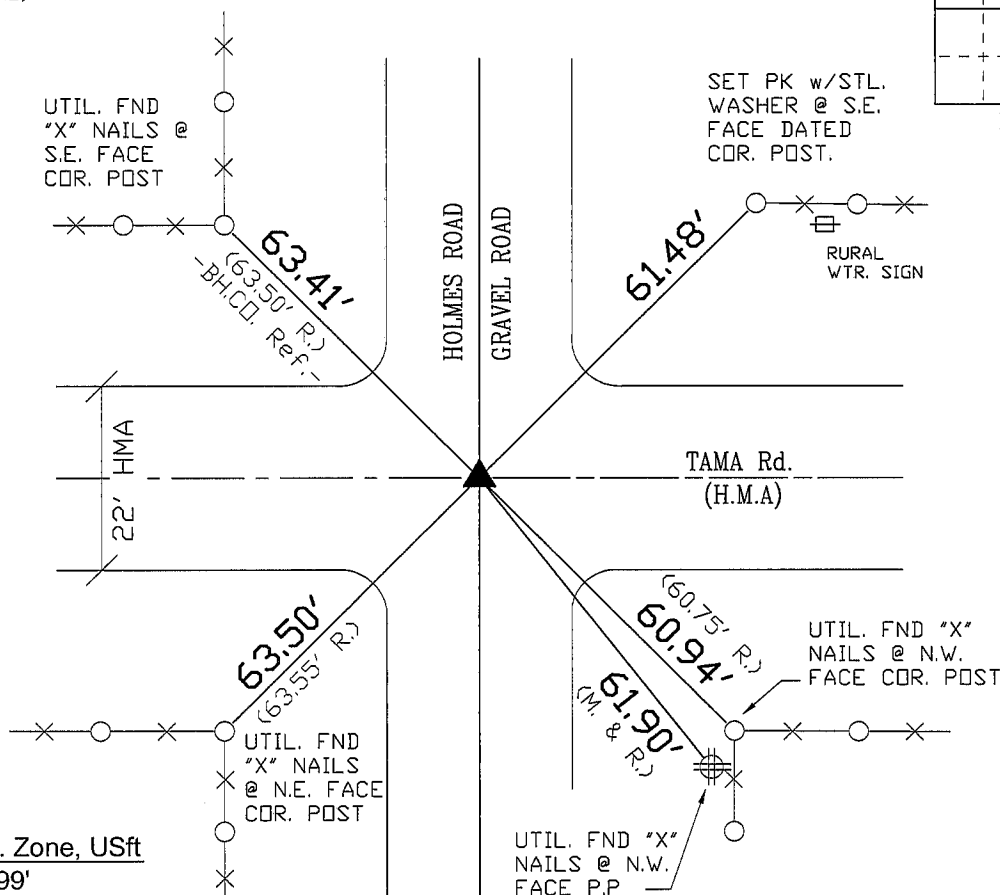

S.P.C., Ia. N. Zone, USft

N=3578440.99'

E=5208910.60'

(NAD83-2007 "BHco07", RTK Obs.)

FIELD SURVEY: G.T. & J.Z. 07/29/08

PREPARED BY: G.T. & J.Z. 4/13/09

CERTIFICATION



I hereby certify that this land surveying document was prepared and the related survey work was performed by me or under my direct personal supervision and that I am a duly licensed Land Surveyor under the laws of the State of Iowa.

Geoffrey Allen Tinker 04/22/09
Geoffrey Allen Tinker (date)

License Number 15748

My license renewal date is December 31, 2010

Pages or sheets covered by this seal:

This Land Corner Certificate Only.

LIST CORNERS TO BE INDEXED

LIST CORNERS TO BE INDEXED			
Corner	Section -	Township -	Range
N.E. COR.	35	87 N	14 W
S.E. COR.	26	87 N	14 W
N.W. COR.	36	87 N	14 W
S.W. COR.	25	87 N	14 W

INDEX OF ABBREVIATIONS

INDEX OF ABBREVIATIONS

(M) = "Measured" Dimension	"RP" = Reflectorless EDM Meas.
(P) = "Platted" Dimension	"MLM" = Indirect Measure
(R) = "Record" Dimension	"CM" = Concrete Monument
(C) = "Calculated" Dimension	"SM" = Survey Marker Spike/Tag
"IGS" = Iowa Geodetic Survey	
"WPA" = Works Progress Admin. Survey	
"G" = per George Miller Survey (BHC Surveyor 1858-1860)	
"S" = per John Ball Survey (BHC Surveyor 1866-1891)	
"N" = per Nathan Barber Survey (BHC Surveyor 1908-1931)	