


UNITED STATES PUBLIC LAND SURVEY CORNER CERTIFICATE
OF

(Show reason for preparing this certificate, the evidence and detailed procedures used in establishing the corner positions and non-
mentation found or placed.)

Monument Description and Remarks: FOUND 4" X 4" CONCRETE MONUMENT WITH BRONZE CAP 2 FEET
BELOW SURFACE SET 1/2" X 18" REBAR 0.25' NORTH AND 0.4' ABOVE

(Show a minimum of three reference ties to durable physical objects, relevant monuments and physical conditions that will enable recovery of the corner.)

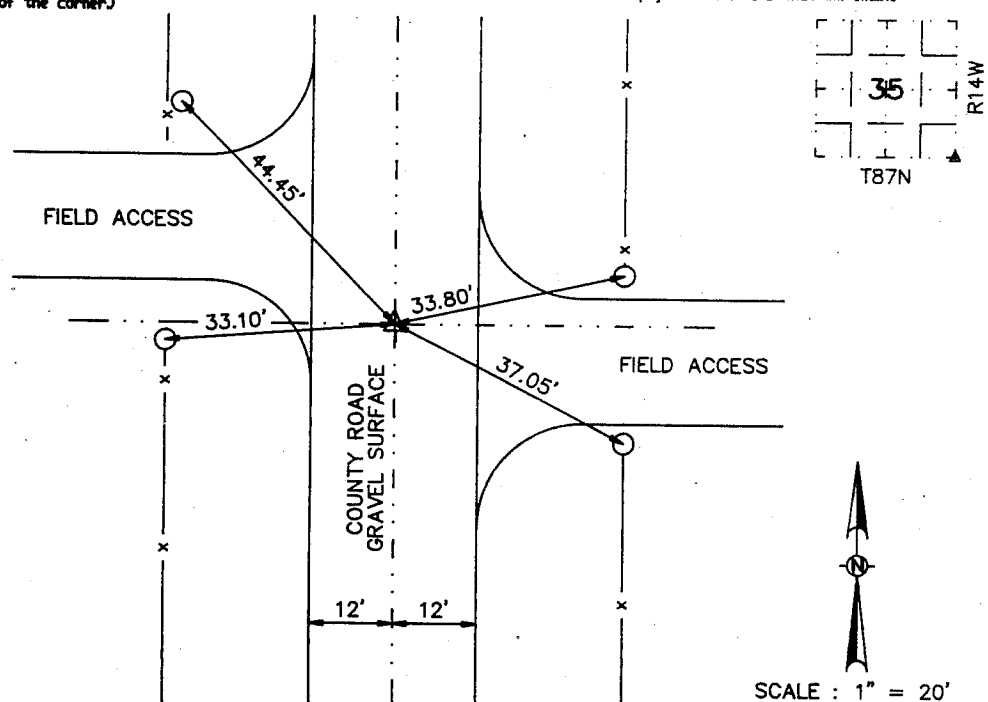

I hereby certify that the survey work was completed and this certificate was prepared by me or under my direct personal supervision and that I am a duly registered land surveyor under the laws of the state of Iowa.

Signature: Kirk D. Eschliman
Name typed or printed: Kirk D. Eschliman

Date: 04-24-92 Rep. No. La. RLS 9961

SEAL



Corners	List Corners to be Indexed Section	Twp	Range
SE	35	87	14