
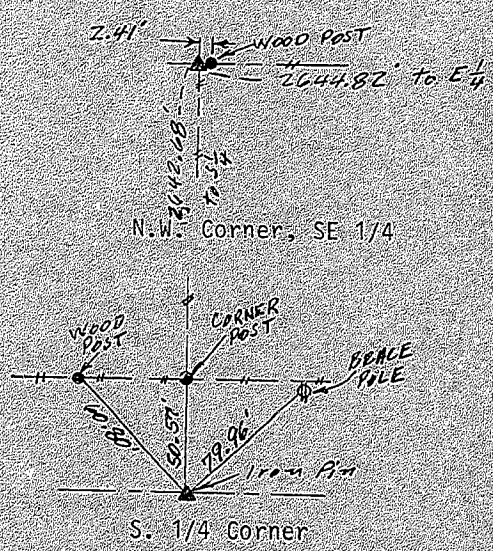
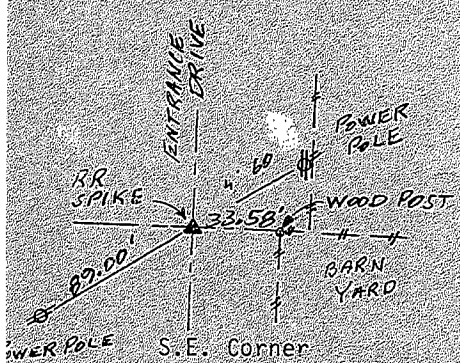
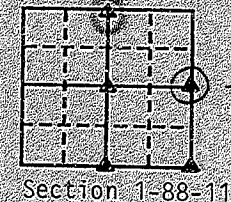


1st
BATCH


Land Survey Monuments situated in Section 1, Township 88 N, Range 11 W, of the Fifth Principal Meridian, Black Hawk County, Iowa.
Previously recorded in _____ in County Recorder's Office
(book, page, document number, etc.)
(Show reason for preparing this certificate, the evidence and detailed procedures used in establishing the corner positions and monumentation found or placed.)
Monument Description and Remarks: Update County Records
N 1/4 Corner, Section 1 - Found IDOT Land Corner Monument
E 1/4 Corner, Section 1 - Found iron pin in ACC Pavement
SE Corner, Section 1 - Found RR spike in gravel drive
S 1/4 Corner, Section 1 - Found iron pin in ACC Pavement
NW Corner, SE 1/4 - Set 1/2" Rebar

P . N . VIEW

(Show a minimum of three reference ties to durable physical objects, relevant monuments and physical conditions that will enable recovery of the corner.)

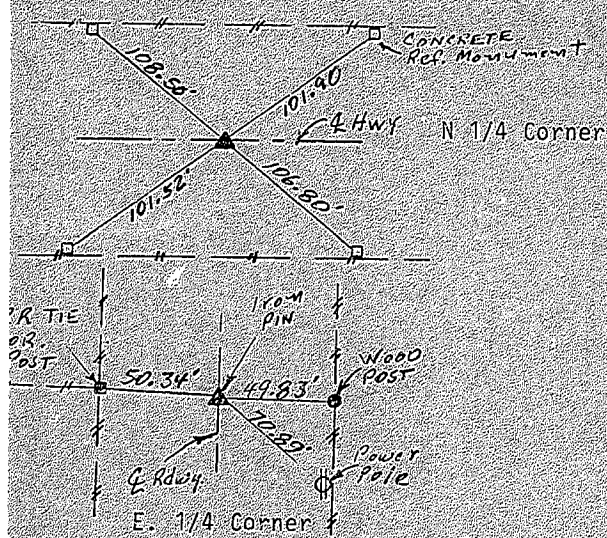

I hereby certify that the survey work was completed and this certificate was prepared by me or under my direct personal supervision and that I am a duly registered land surveyor under the laws of the state of Iowa.
Signature: John R. Crawford
Name: John R. Crawford, R.L.S.
Date: 11/4/91 Reg. No. 7474

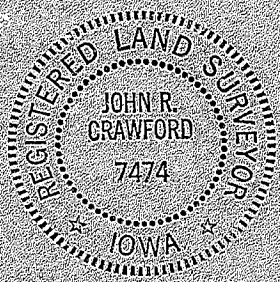

Corners	List Corners to be Indexed	Section	Twp	Range
N 1/4 Cor.	1	88	11	
E 1/4 Cor.	1	88	11	
SE Corner	1	88	11	
S 1/4 Cor.	1	88	11	
NW Corner, SE 1/4	1	88	11	

MISC. Bk. 298 p. 781