

PAUL HELLAND

Jeffrey P. Helland, 1107 Technology Parkway, Cedar Falls, Iowa 50613-6951, (319)-266-0161

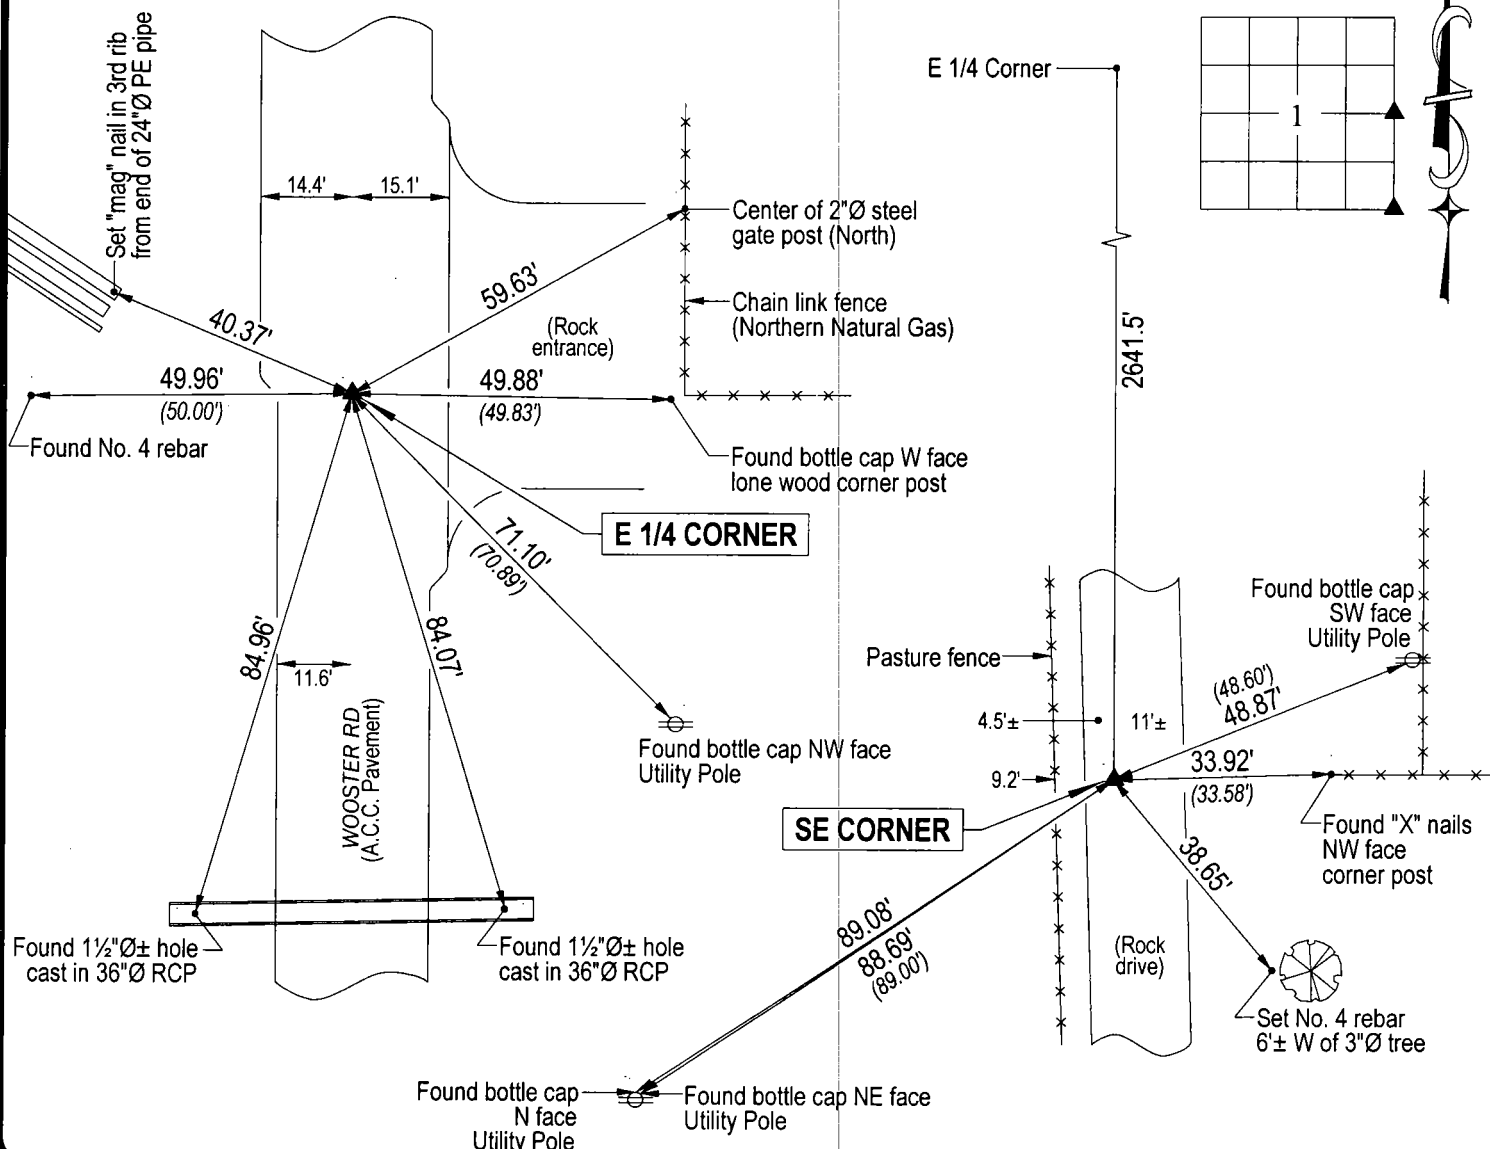
UNITED STATES PUBLIC LAND SURVEY CORNER CERTIFICATE  
OFLAND SURVEY MONUMENTS SITUATED IN SECTION NO. 1, TOWNSHIP NO. 88 NORTH, RANGE  
NO. 11 WEST OF THE FIFTH PRINCIPAL MERIDIAN, BLACK HAWK COUNTY, IOWA.  
PREVIOUSLY RECORDED IN BOOK 298, PAGE 781.(SHOW REASON FOR PREPARING THIS CERTIFICATE, THE EVIDENCE AND DETAILED PROCEDURES USED IN ESTABLISHING THE  
CORNER POSITIONS AND MONUMENTATION FOUND OR PLACED.)

## MONUMENT DESCRIPTION AND REMARKS:

Monumentation has changed from 298 Misc. 781. Survey completed in the SE 1/4 of Sec. 1-T88N-R11W.

- E 1/4 CORNER: 298 Misc. 781 calls for "iron pin". Found No. 4 rebar corresponding to position established in 298 Misc. 781 and "Emerald Acres Estates". Corner is 0.2' below A.C.C. pavement (recently laid). Corner overlaid on 5/20/2004 with 4"± of A.C.C. pavement.
- SE CORNER: 298 Misc. 781 calls for "RR spike". Said "RR spike" was set East of concrete monument for magnetic relocation per Plat of Survey dated 3/10/1980 recorded in 232 Misc. 479. Found concrete monument w/brass cap 0.1' deep in rock drive. Concrete surrounding brass cap is deteriorated. Magnetic sounding is on the E-SE side of concrete monument.

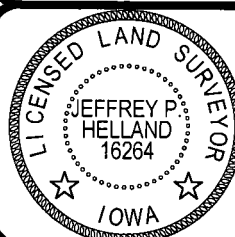
## PLAN VIEW

(SHOW A MINIMUM OF THREE REFERENCE TIES TO DURABLE PHYSICAL OBJECTS, RELEVANT MONUMENTS AND PHYSICAL  
CONDITIONS THAT WILL ENABLE RECOVERY OF THE CORNER.)

HELLAND ENGINEERING &amp; SURVEYING, LTD.

1107 Technology Parkway  
Cedar Falls, Iowa 50613-6951  
(319)-266-0161

(00.00') - Recorded As File Name: 04-207c1.drg

I hereby certify that this land surveying document was prepared  
and the related survey work was performed by me or under my  
direct personal supervision and that I am a duly licensed Land  
Surveyor under the laws of the State of Iowa.*Jeffrey P. Helland 6/9/04*  
Jeffrey P. Helland  
License Number 16264  
My license renewal date is December 31, 2005.  
All pages or sheets are covered by this seal except:

## LIST CORNERS TO BE INDEXED

| CORNER       | SECTION | TOWNSHIP | RANGE |
|--------------|---------|----------|-------|
| E 1/4 CORNER | 1       | 88N      | 11W   |
| SE CORNER    | 1       | 88N      | 11W   |