

File 2010-00006275

PH.# (319) 833-3008
FAX.# (319) 833-3139

SLSI 9-94
CERT 03-09

Land Survey Monuments situated in Section 04 , Township 88 N ,
Range 11 W , of the Fifth Principal Meridian, BLACK HAWK County, Iowa.
Previously recorded in Fee Book N/A, Page N/A, in County Recorder's Office.

(Show reason for preparing this certificate): The corner monument has been Replaced or Modified, per Ia. Code 355.11(1)(c)

(Evidence and detailed procedures used in establishing the corner position(s) and monumentation found or placed.)

Monument Description and Remarks: N. 1/4 COR. FOUND 2½"Ø IADOT ALUM. CAP IN ACC CORE HOLE, WITH NO CURRENT CERTIFICATE ON RECORD. CLEANED CORE HOLE DOWN ±5" Dp. THRU EXIST. ACC OVERLAY TO PCC PAVEMENT, AND FOUND LEAD PLUG IN PCC PAVEMENT. TEMP. REF. w/RTK GPS (TWO LINE w/WT. AVG.), AND MILLED 2" EXIST. ACC OVERLAY & ADDED 5" H.M.A./A.C.C. OVERLAY. CORNER RESET WITH #5 (5/8") x ±7" L. REBAR PER RTK GPS REF., AND RETIED. LAND CORNER IS LOC. @ 0.8' NORTH OF NEW C.L. PAVING JOINT AND CORNER CALC.'S @ "1.64' NORTH" OF CALC.'ED TRUE CORNER (CLOSING) ONTO SOUTH LINE S.W. 1/4 OF SECTION 34-T89-R11, AS OBSERVED. IADOT 1955 PAVING PLAN @ CORNER SHOWN FOR HISTORICAL REFERENCE REGARDING MONUMENTATION.



NOTE: ALL DISTANCES PLUMB/HORIZ.
(H.D.), "UNLESS DENOTED".

"NOT TO SCALE"

BHco Hist. Ties: BK. #1001 p.04 88-11


FIELD BOOK: BHco. #488 p.46 (#1014)

(Show a minimum of three reference ties to durable physical objects, relevant monuments and physical conditions that will enable recovery of the corner.)

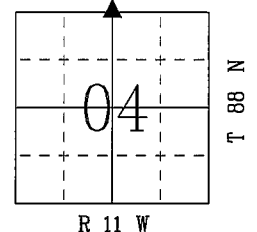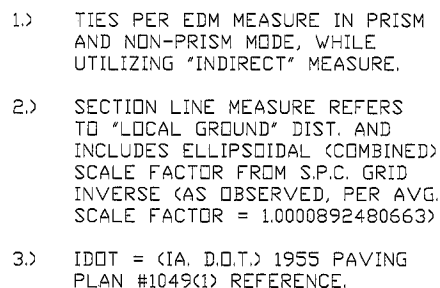

SET MAG NAIL
w/WASHER @
W-SW. FACE OF
P.P. LOC. 26" HT.

NO COR. REF.
PER IADOT 1955
PAVING PLANS,
w/FENCE TO N.
ONLY. ➡

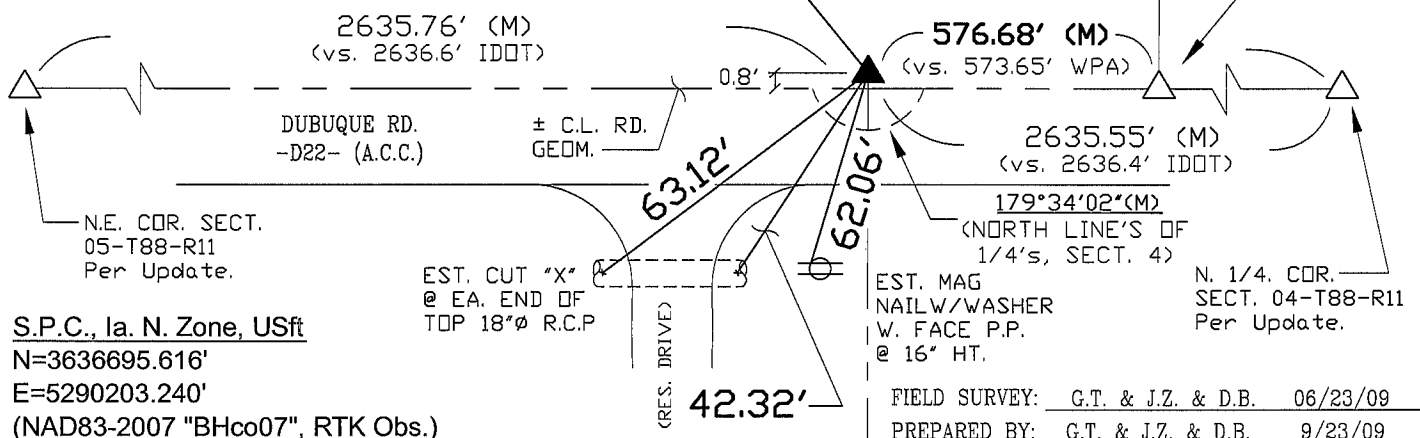

LIST CORNERS TO BE INDEXED



I hereby certify that this land surveying document was prepared and the related survey work was performed by me or under my direct personal supervision and that I am a duly licensed Land Surveyor under the laws of the State of Iowa.

Geoffrey Allen Tinker 09/23/2009 (date)

License Number 15748

My license renewal date is December 31, 2010

Pages or sheets covered by this seal:

This Land Corner Certificate Only.

<u>Corner</u>	<u>Section</u>	<u>Township</u>	<u>Range</u>
N. 1/4 Cor.	04	88 N	11 W

INDEX OF ABBREVIATIONS

INDEX OF ABBREVIATIONS

(M) = "Measured" Dimension	"NP" = Reflectorless EDM Meas.
(P) = "Platted" Dimension	"MLM" = Indirect Measure
(R) = "Record" Dimension	"CM" = Concrete Monument
(C) = "Calculated" Dimension	"SM" = Survey Marker Spike/Tag
"GS" = Iowa Geodetic Survey	
"WPA" = Works Progress Admin. Survey	
"Q" = per George Miller Survey (BHC Surveyor 1858-1860)	
"S" = per John Ball Survey (BHC Surveyor 1866-1891)	
"N" = per Nathan Barber Survey (BHC Surveyor 1908-1931)	