

UNITED STATES PUBLIC LAND SURVEY CORNER CERTIFICATE

OF

Land Survey Monuments situated in Section 4, Township 88 N, Range 11 W, of the Fifth Principal Meridian, BLACK HAWK County, Iowa.
Previously recorded in MISC - BK 325 p. 260 in County Recorder's Office.



(Show reason for preparing this certificate, the evidence and detailed procedures used in establishing the corner positions and monumentation found or placed.)

Monument Description and Remarks: FOUND DOT ALUM. CAP

PLAN - VIEW

(Show a minimum of three reference ties to durable physical objects, relevant monuments and physical conditions that will enable recovery of the corner.)

4" x 4" CONCRETE
MONUMENT w/ 1/2" IR

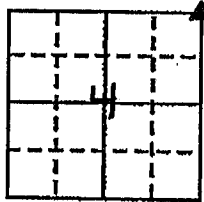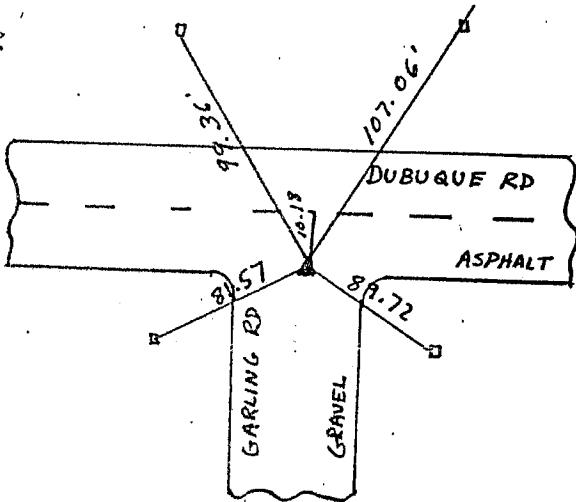

I hereby certify that the survey work was completed and this land surveying document was prepared by me or under my direct personal supervision and that I am a duly registered land surveyor under the laws of the state of Iowa

Signature: Myron Scheebe
Name typed or printed: Myron Scheebe

Date: 10-15-98 Reg. No. 2807

My registration renewal date is December 31, 1999

Corners	List Corners to be Indexed		
	Section	Twp	Range
NE COR.	4	88 N	11 W

SEAL

