

UNITED STATES PUBLIC LAND SURVEY CORNER CERTIFICATE


OF

Land Survey Monuments situated in Section 5, Township 88 North, Range 11 East, of the Fifth Principal Meridian, BLACK HAWK County, Iowa.
Previously recorded in (not applicable) in County Recorder's Office.
(Book, page, document number, etc.)

(Show reason for preparing this certificate, the evidence and detailed procedures used in establishing the corner positions and monumentation found or placed.)
Monument Description and Remarks: FOUND NO. 5 IRON BAR,
RE-TIED CORNER.

PLAN - VIEW

(Show a minimum of three reference ties to durable physical objects, relevant monuments and physical conditions that will enable recovery of the corner.)

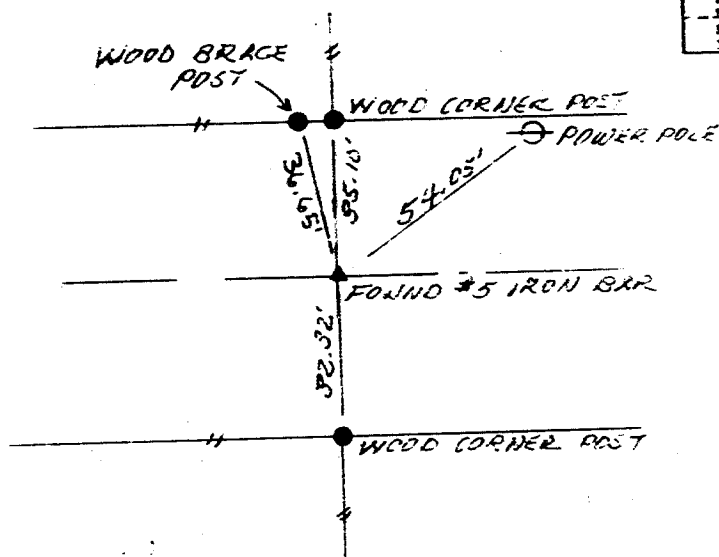


I hereby certify that the survey work was completed and this certificate was prepared by me or under my direct personal supervision and that I am a duly registered land surveyor under the laws of the state of Iowa.

Signature: Harold F. Michels

Name typed or printed: Harold F. Michels

Date: MAR. 31, 92 Reg. No. 3862

SEAL

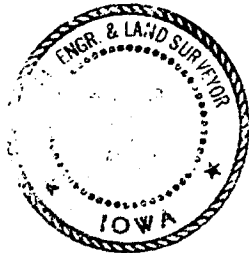

Corners	List Corners to be Indexed Section	Twp	Range
SE CORNER SW 4	5	88	11

BOOK 300 PAGE 600