

PREPARED BY: BLACK HAWK COUNTY ENGINEERS OFFICE  
316 E. FIFTH STREET, ROOM 211 WATERLOO, IOWA 50703  
PH.# (319) 833-3008  
FAX# (319) 833-3139  
SLSI 9-94  
CERT 03-09


UNITED STATES PUBLIC LAND SURVEY CORNER CERTIFICATE OF  
Land Survey Monuments situated in Section 06, Township 88 N,  
Range 11 W, of the Fifth Principal Meridian, BLACK HAWK County, Iowa.  
Previously recorded in Fee Book N/A, Page N/A, in County Recorder's Office.

(Show reason for preparing this certificate): The corner monument has been Replaced or Modified, per Ia. Code 355.11(1)(c)  
(Evidence and detailed procedures used in establishing the corner position(s) and monumentation found or placed.)



Monument Description and Remarks: N.E. COR. FOUND 2 1/2" Ø 1" DOT ALUM. CAP IN ACC CORE HOLE, WITH NO CUR. CERT. ON RECORD. CLEANED CORE HOLE DOWN ±5" Dp. THRU EXIST. ACC OVERLAY TO PCC PAVEMENT, AND FOUND LEAD PLUG w/"+" IN PCC SLAB. TEMP. REF. w/RTK GPS (TWO LINE w/WT. AVG.), AND MILLED 2" EXIST. ACC OVERLAY & ADDED 5" H.M.A./A.C.C. OVERLAY. CORNER RESET WITH #5 (5/8") x ±7" L. REBAR PER RTK GPS REF., AND RETIED. LAND CORNER IS LOC. @ 5.0' SOUTH OF NEW C.L. PAVING JOINT, AND CALC.'S @ "0.35' SOUTH" FROM CALC.'ED TRUE CORNER (CLOSING) ONTO SOUTH LINE OF S.E. 1/4 SECTION 32-T89-R11, AS OBSERVED. IA. DOT 1955 PAVING PLAN DETAILS DENOTED FOR HISTORICAL REFERENCE. REFER TO ADDITIONAL DETAILS REGARDING GEOM. REF. TO S.E. COR. SECT. 32-T89-R11, PER UPDATED RECORD.

NOTE: ALL DISTANCES PLUMB/HORIZ. (H.D.), "UNLESS DENOTED".  
PLAN VIEW  
"NOT TO SCALE"  
BHco Hist. Ties: BK. #1001 p.06 88-11  
FIELD BOOK: BHco. #488 p.46 (#1008)


(Show a minimum of three reference ties to durable physical objects, relevant monuments and physical conditions that will enable recovery of the corner.)

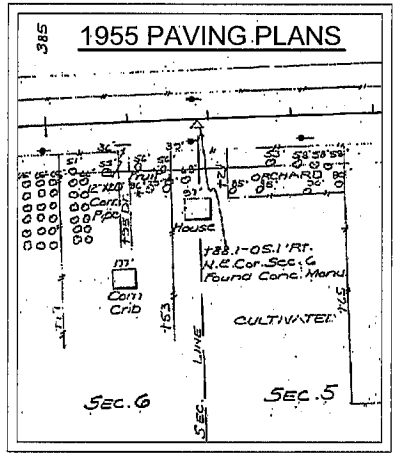

- 1.) TIES PER EDM MEASURE IN PRISM. AND NON-PRISM MODE, WHILE UTILIZING "INDIRECT" MEASURE.
- 2.) SECTION LINE MEASURE REFERS TO "LOCAL GROUND" DIST. AND INCLUDES ELLIPSOIDAL (COMBINED) SCALE FACTOR FROM S.P.C. GRID INVERSE (AS OBSERVED, PER AVG. SCALE FACTOR = 1.0000892480663)
- 3.) IDOT = (IA. D.O.T.) 1955 PAVING PLAN #1049(1) REFERENCE.

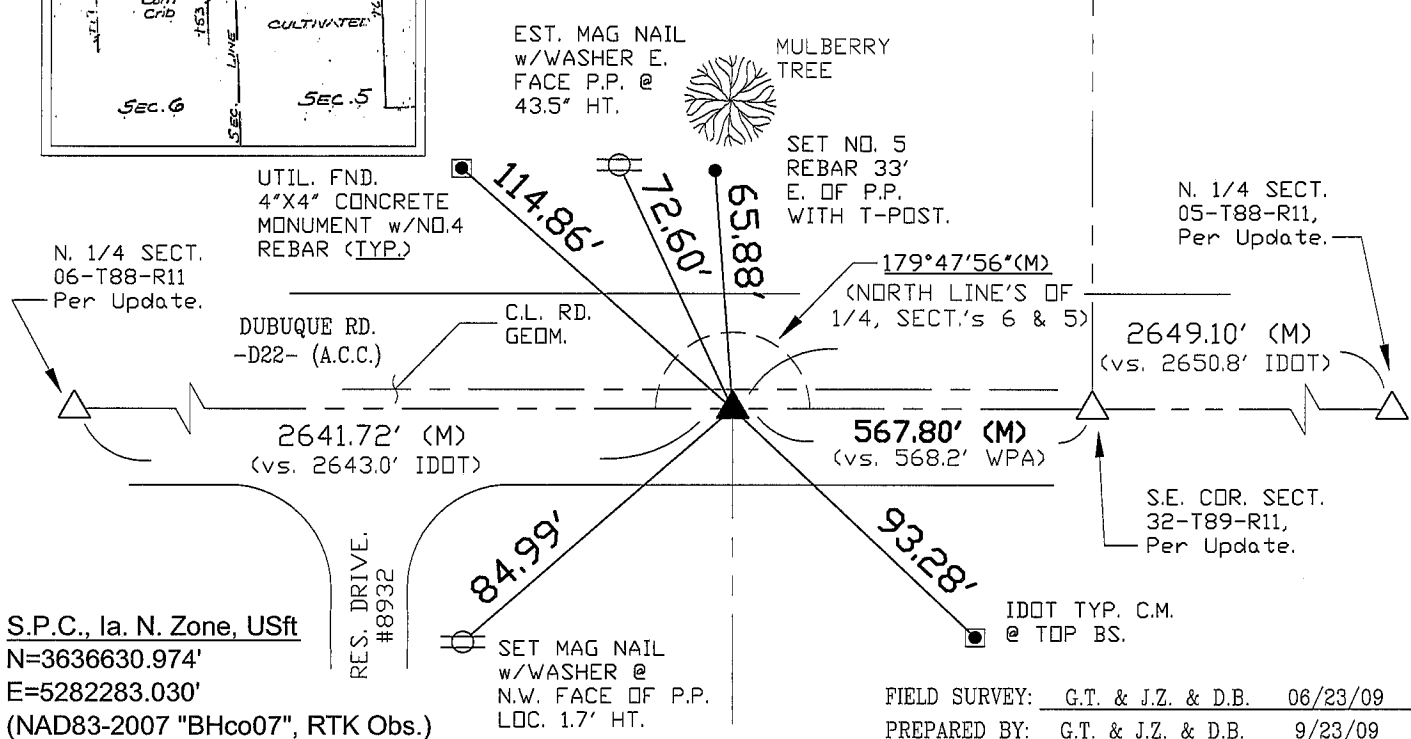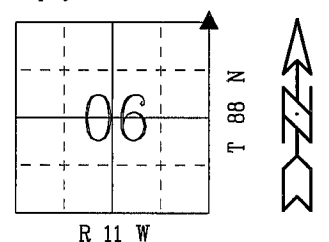

CERTIFICATION

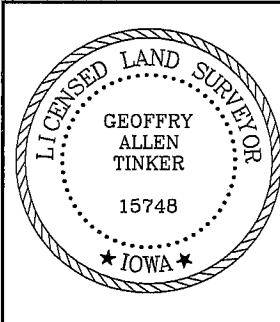

I hereby certify that this land surveying document was prepared and the related survey work was performed by me or under my direct personal supervision and that I am a duly licensed Land Surveyor under the laws of the State of Iowa.  
*Geoffrey Allen Tinker* 09/23/2009  
Geoffrey Allen Tinker (date)  
License Number 15748  
My license renewal date is December 31, 2010  
Pages or sheets covered by this seal:  
This Land Corner Certificate Only.

LIST CORNERS TO BE INDEXED

Corner	Section -	Township -	Range
N.E. Cor.	06	88 N	11 W
N.W. Cor.	05	88 N	11 W

INDEX OF ABBREVIATIONS

- (M) = "Measured" Dimension  
(P) = "Platted" Dimension  
(R) = "Record" Dimension  
(C) = "Calculated" Dimension  
"IGS" = Iowa Geodetic Survey  
"WPA" = Works Progress Admin. Survey  
"φ" = per George Miller Survey (BHco Surveyor 1858-1860)  
"B" = per John Ball Survey (BHco Surveyor 1866-1891)  
"N" = per Nathan Barber Survey (BHco Surveyor 1908-1931)  
"NP" = Reflectorless EDM Meas.  
"MLM" = Indirect Measure  
"CM" = Concrete Monument  
"SM" = Survey Marker Spike/Tag