REC FEE E FEE TRAN FEE **REV FEE** GF



Doc ID: 005604410001 Type: GEN Recorded: 10/23/2014 at 02:48:32 PM Fee Amt: \$0.00 Page 1 of 1 Black Hawk County Iowa JUDITH A MCCARTHY RECORDER

File 2015-00007071

PREPARED BY:

BLACK HAWK COUNTY ENGINEERS OFFICE 316 E. FIFTH STREET, ROOM 211

WATERLOO, IOWA 50703

PH.# (319) 833-3008 FAX.# (319) 833-3139

SLSI 9-94 BHC0 03-09

UNITED STATES PUBLIC LAND SURVEY CORNER CERTIFICATE OF

Land Survey Monuments situated in Section\_\_\_ 7 \_\_\_ , Township<u>88 N</u> Range 11 W, of the Fifth Principal Meridian, BLACK HAWK County, Iowa. Previously recorded in Misc. Book N/A, Page N/A, in County Recorder's Office. (Show reason for preparing this certificate): There is No Certificate for the corner on file with County Recorder, per Ia. Code 355.11(1)(a).


(Evidence and detailed procedures used in establishing the corner position(s) and monumentation found or placed.)

Monument Description and Remarks: N.E. COR.:

FOUND 20d NAIL w/ RED FABRIC RIBBON @ ±1" DP., WITH RECORD CORNER REFERENCED AS

"FOUND PIN" PER PLAT OF SURVEY IN MISC. Bk. 300 p. 411 (1992). CORNER ALSO

REFERENCED PER IGNOT CORNER STONE SURVEY (PLS #3513) OF HIGHWAY 520 PROJECT (DATED 1-25-1977), AS FOUND IRON PIN 3" DEEP OVER STD. WPA CONC. MONUMENT. ACCEPTED CORNER AS FOUND, TIED AND FILED FOR PUBLIC RECORD, AS PART OF R.O.W. ACQUISITION AND PROJECT SURVEY FOR BHCO. CANFIELD RD. RECONSTRUCTION PROJECT

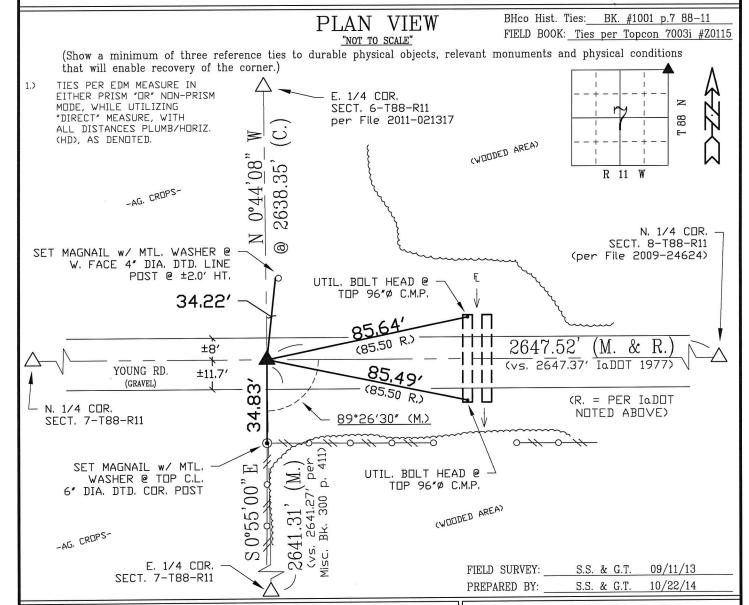

## CERTIFICATION



I hereby certify that this land surveying document was prepared and the related survey work was performed by me or under my direct personal supervision and that I am a duly licensed Land Surveyor under the laws of the State of Lowa

10/22/2014 Geoffry Allen Tinker (date)

15748 License Number

My license renewal date is December 31, 2014

Pages or sheets covered by this seal:

This Land Corner Certificate Only.

	LIST	CORNERS	TO	BE	INDEX	ED
Corner		Section	_	Tor	wnship	_

Range 88 N 11 W N.E. Cor. 11 W N.W. Cor. 8 88 N 6 88 N 11 W S.E. Cor. 88 N 11 W S.W. Cor. INDEX OF ABBREVIATIONS

| INDEA OF ABBREVIATIONS
