



Doc ID: 006907300001 Type: GEN
Recorded: 11/13/2015 at 08:47:44 AM
Fee Amt: \$7.00 Page 1 of 1
Black Hawk County Iowa
SANDIE L. SMITH RECORDER

File 2016-00009086

Prepared by & Return to: Herald - Reicks Surveying, 10 East Main Street, New Hampton, IA 50659, Ph. 641-394-2725

UNITED STATES PUBLIC LAND SURVEY CORNER CERTIFICATE

Land Survey Monuments situated in Section 7, Township 88 North, Range 11 West of the Fifth Principal Meridian, Black Hawk County, Iowa. Previously recorded in Misc. Bk. 320, Pg. 54 in the County Recorder's office.

This certificate is being prepared in compliance with Iowa Code Chapter 355.11 because:



- ☐ There is no certificate on file for this corner.
- ☒ There are no longer three valid ties of record.
- ☐ There are changes to reference ties of record.
- ☒ There is change of monumentation of record.
- ☐ To clarify description of record monument (ties).


Monument Description and Remarks:

SE Corner: Set Survey Mark Nail w/Stainless Steel Washer PLS 19211 at previous location (Found 5/8"Ø rebar in AC Mat) with coordinates obtained prior to highway reconstruction, Project #STP-S-CO07(132)--5E-07.

Section Corner = P.I. Station 105+74.00

PLAN - VIEW

(Show a minimum of three reference ties to durable physical objects, relevant monuments and physical conditions that will enable recovery of the corner.)

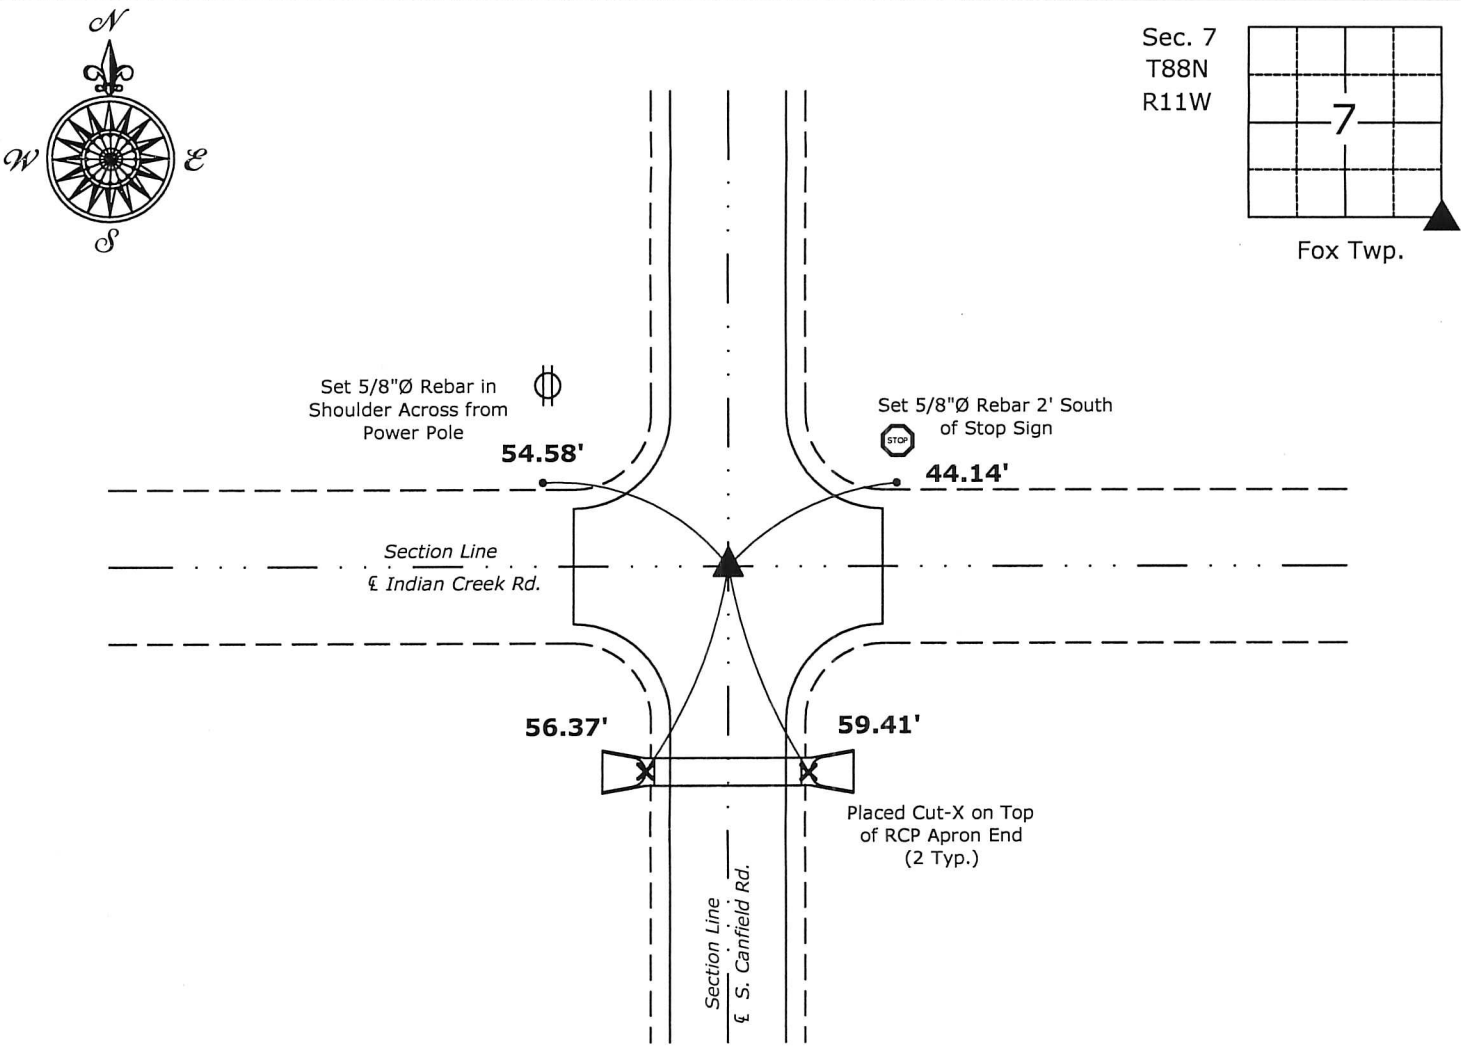

SE Corner Section 7-88-11
Set Survey Mark Nail w/Stainless Steel Washer PLS 19211



I hereby certify that this land surveying document was prepared and the related survey work was performed by me or under my direct personal supervision and that I am a duly licensed Land Surveyor under the laws of the State of Iowa.
Kirk D. Reicks 11-10-15
Kirk D. Reicks Date:
License number 19211
My license renewal date is December 31, 2016.
Sheets covered by this seal: Individual sheet only

List Corners to be Indexed			
Corners	Section	Twp.	Range
SE	7	88	11
Project Number: 2015-344			
FB: Black Hawk County 10, Pg. 2			