

UNITED STATES PUBLIC LAND SURVEY CORNER CERTIFICATE

SLSI 9-90

OF


Previously recorded in N/A in County Recorder's Office.

(Show reason for preparing this certificate, the evidence and detailed procedures used in establishing the corner positions and monumentation found or placed.)

USING IOWA D.O.T. TIES CORNERSTONE SURVEY PROJ. I-380-7(19)-01-07
10-5-1977.

PLAN - VIEW

(Show a minimum of three reference ties to durable physical objects, relevant monuments and physical conditions that will enable recovery of the corner.)

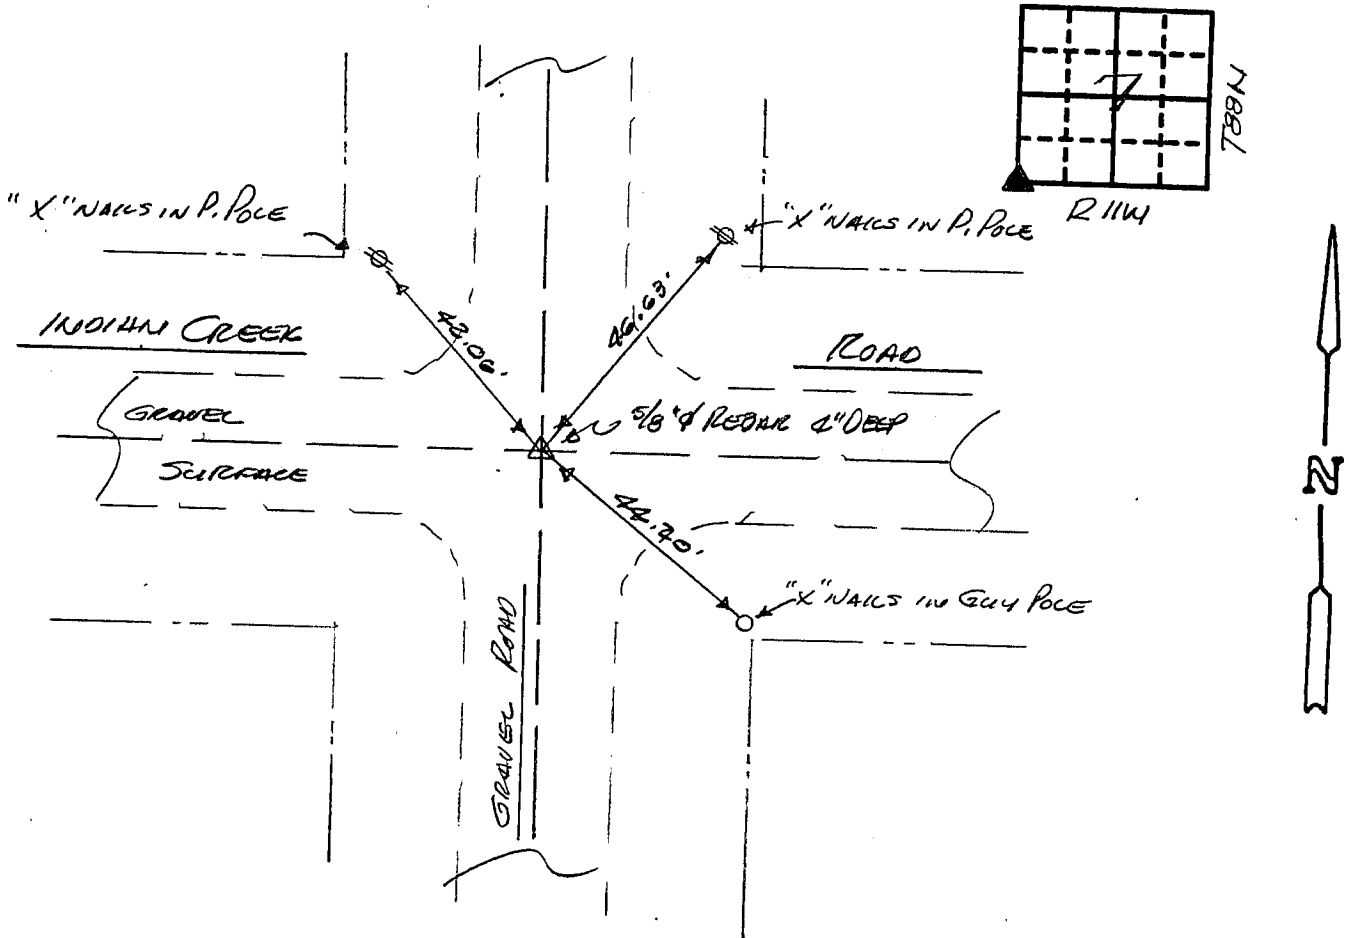

I hereby certify that the survey work was completed and this certificate was prepared by me or under my direct personal supervision and that I am a duly registered land surveyor under the laws of the state of Iowa.

Signature: F. William King
Name typed or printed: F. William King
Date: 8-30-1991 Reg. No. 8033



SEAL

Corners	List Corners to be Indexed	Section	Twp	Range

MISC. BK. 297 p. 575