

BLACK HAWK COUNTY ENGINEER

PREPARED BY: BLACK HAWK COUNTY ENGINEERS OFFICE PH.# (319) 833-3008 SLSI 9-94

316 E. FIFTH STREET, ROOM 211 WATERLOO, IOWA 50703 FAX.# (319) 833-3139 CERT 12-96

UNITED STATES PUBLIC LAND SURVEY CORNER CERTIFICATE OF
Land Survey Monuments situated in Section 11, Township 88 N,
Range 11 W, of the Fifth Principal Meridian, BLACK HAWK County, Iowa.
Previously recorded in Misc. Book N/A, Page N/A, in County Recorder's Office.


(Show reason for preparing this certificate, the evidence and detailed procedures used in establishing the corner positions and monumentation found or placed.)

Monument Description and Remarks: FOUND #5 RBR. PRIOR TO RESURFACING.
RE-EST. #5 REBAR x 5" L. FLUSH w/ ACC @ +/- C.L. INTERSECTION w/
GRAVEL RD. SOUTH AND ALIGNED w/ FENCE TO NORTH.

CORNER UPDATED DUE TO ACC RESURFACING PROJECT, MAY 2004.


PLAN - VIEW

(Show a minimum of three reference ties to durable physical objects, relevant monuments and physical conditions that will enable recovery of the corner.)

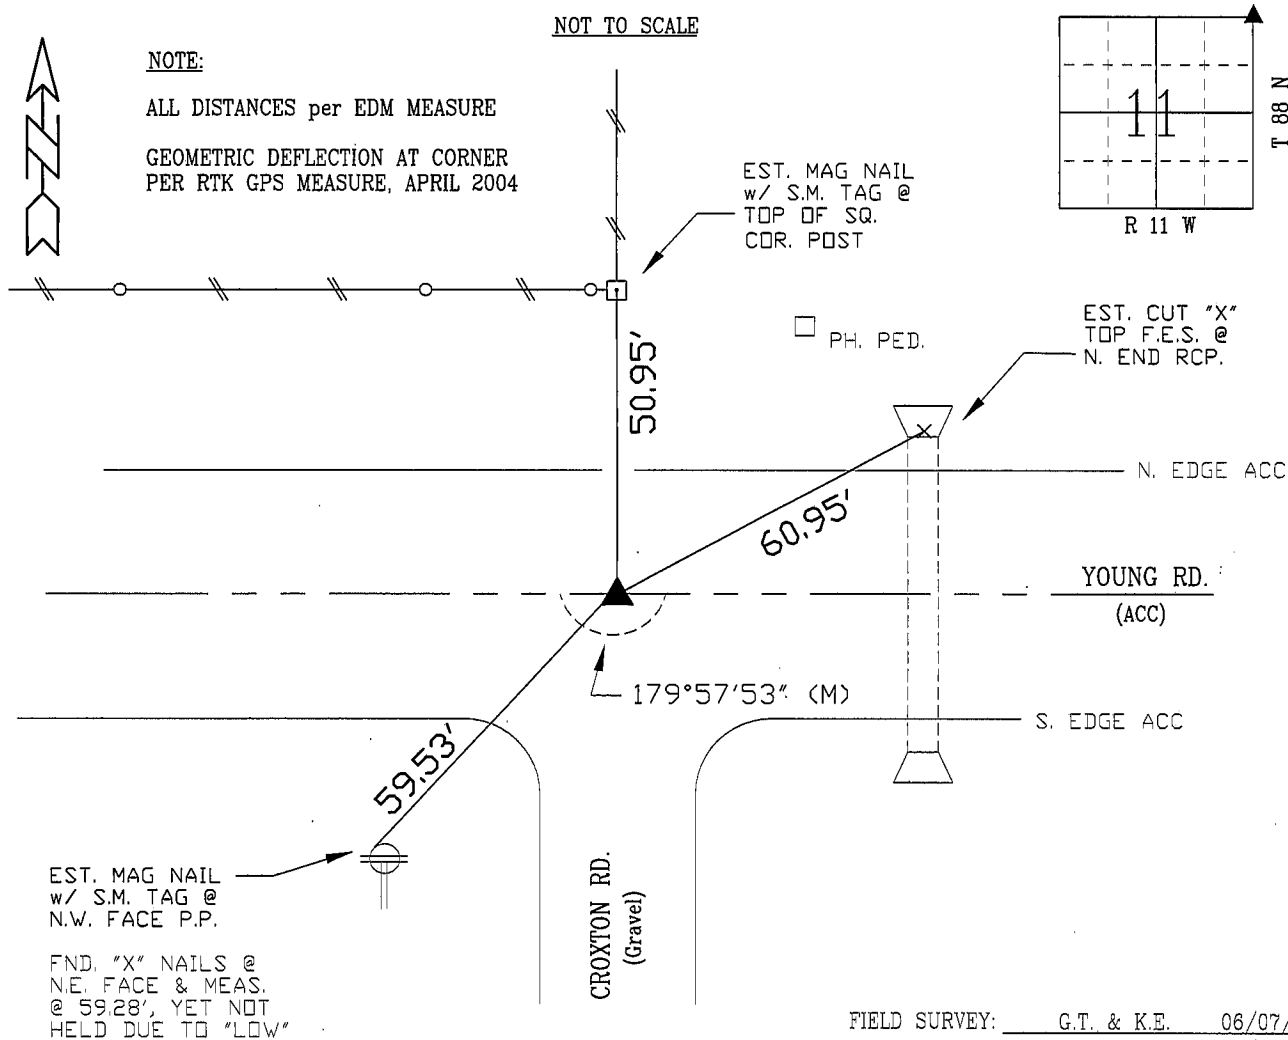

FIELD SURVEY: G.T. & K.E. 06/07/04
PREPARED BY: G. TINKER 07/09/04

CERTIFICATION

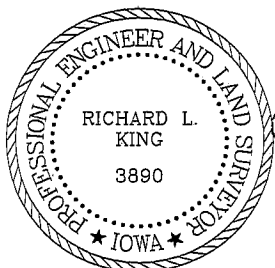

I hereby certify that this land surveying document was prepared and the related survey work was performed by me or under my direct personal supervision and that I am a duly licensed Land Surveyor under the laws of the State of Iowa.

Richard L. King 7/12/04 (date)
Richard L. King
License Number 3890
My license renewal date is December 31, 2005
Pages or sheets covered by this seal:
This Land Corner Certificate Only.

LIST CORNERS TO BE INDEXED

Corner	Section	Township	Range
N.E. COR.	11	88 N	11 W
N.W. COR.	12	88 N	11 W
S.E. COR.	2	88 N	11 W
S.W. COR.	1	88 N	11 W