

UNITED STATES PUBLIC LAND SURVEY CORNER CERTIFICATE

OF



Land Survey Monuments situated in Section 12, Township 86, Range 11, of the Fifth Principal Meridian, BLACK HAWK County, Iowa.
Previously recorded in Book 299, Page 943

(Show reason for preparing this certificate, the evidence and detailed procedures used in establishing the corner positions and monumentation found or placed.)

Monument Description and Remarks: SURVEY DONE IN SE 1/4 SEC 7 T86 R11
NW CORNER SEC 12 T86 R11 FOUND PIN IN CENTER OF ROAD.

PLAN - VIEW

(Show a minimum of three reference ties to durable physical objects, relevant monuments and physical conditions that will enable recovery of the corner.)

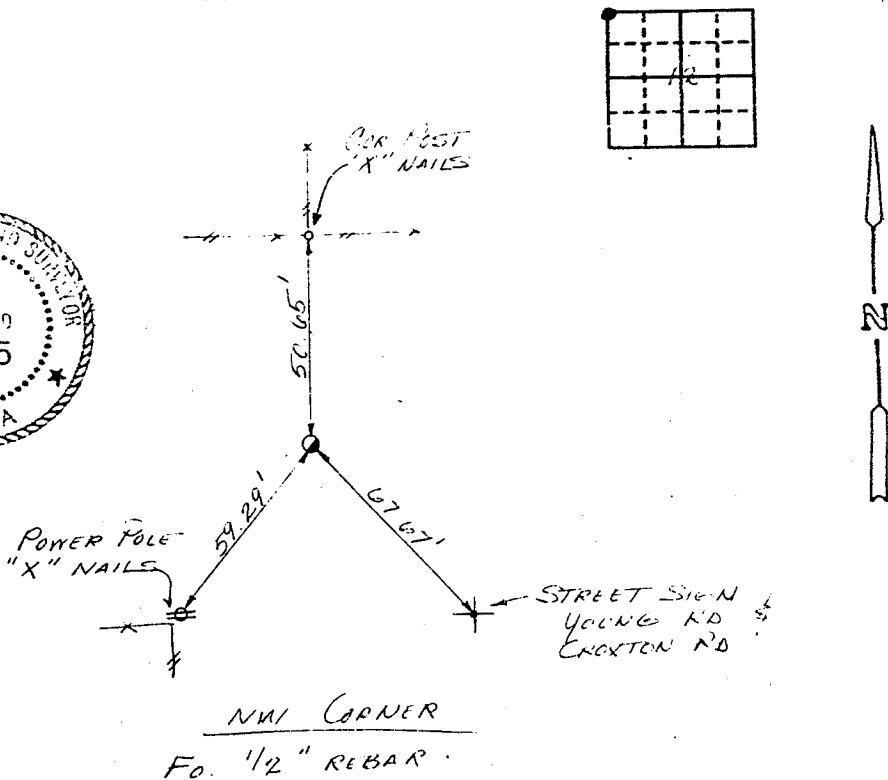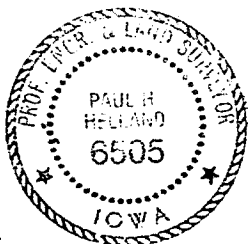

I hereby certify that the survey work was completed and this certificate was prepared by me or under my direct personal supervision and that I am a duly registered land surveyor under the laws of the state of Iowa.

Paul H. Holland 2/4/82
REGISTERED LAND SURVEYOR NO. 6505

SEAL

List Corners to be Indexed

Corners	Section	Twp	Range
NW	12	86	11