

PROOF FILED FOR RECORD NOV 4, 2002, AT 4:00 P.M. FEE 1-5.00

COMPARED

BLACK HAWK COUNTY RECORDER

HELLAND ENGINEERING & SURVEYING 1107 TECHNOLOGY PKWY CEDAR FALLS IA 50613

Paul H. Helland, 1107 Technology Parkway, Cedar Falls, Iowa 50613-6951, (319)-266-0161

UNITED STATES PUBLIC LAND SURVEY CORNER CERTIFICATE

LAND SURVEY MONUMENTS SITUATED IN SECTION NO. 13, TOWNSHIP NO. 88 NORTH, RANGE
NO. 11 WEST OF THE FIFTH PRINCIPAL MERIDIAN, BLACK HAWK COUNTY, IOWA.
PREVIOUSLY RECORDED IN BOOK _____, PAGE _____.

(SHOW REASON FOR PREPARING THIS CERTIFICATE, THE EVIDENCE AND DETAILED PROCEDURES USED IN ESTABLISHING THE CORNER POSITIONS AND MONUMENTATION FOUND OR PLACED.)


MONUMENT DESCRIPTION AND REMARKS:

NO CORNER CERTIFICATE ON FILE. SURVEY DONE IN SE 1/4 OF SEC. 13-T88N-R11W & NE 1/4 OF SEC. 24-T88N-R11W.

N 1/4 CORNER: ALL BLACK HAWK COUNTY ENGINEER REFERENCE TIES HAVE BEEN OBLITERATED. FOUND NO. 5 REBAR IN A.C.C. PAVEMENT. NO. 5 REBAR IS IN CENTER OF LARGE PAINTED WHITE "X".

PLAN VIEW


(SHOW A MINIMUM OF THREE REFERENCE TIES TO DURABLE PHYSICAL OBJECTS, RELEVANT MONUMENTS AND PHYSICAL CONDITIONS THAT WILL ENABLE RECOVERY OF THE CORNER.)

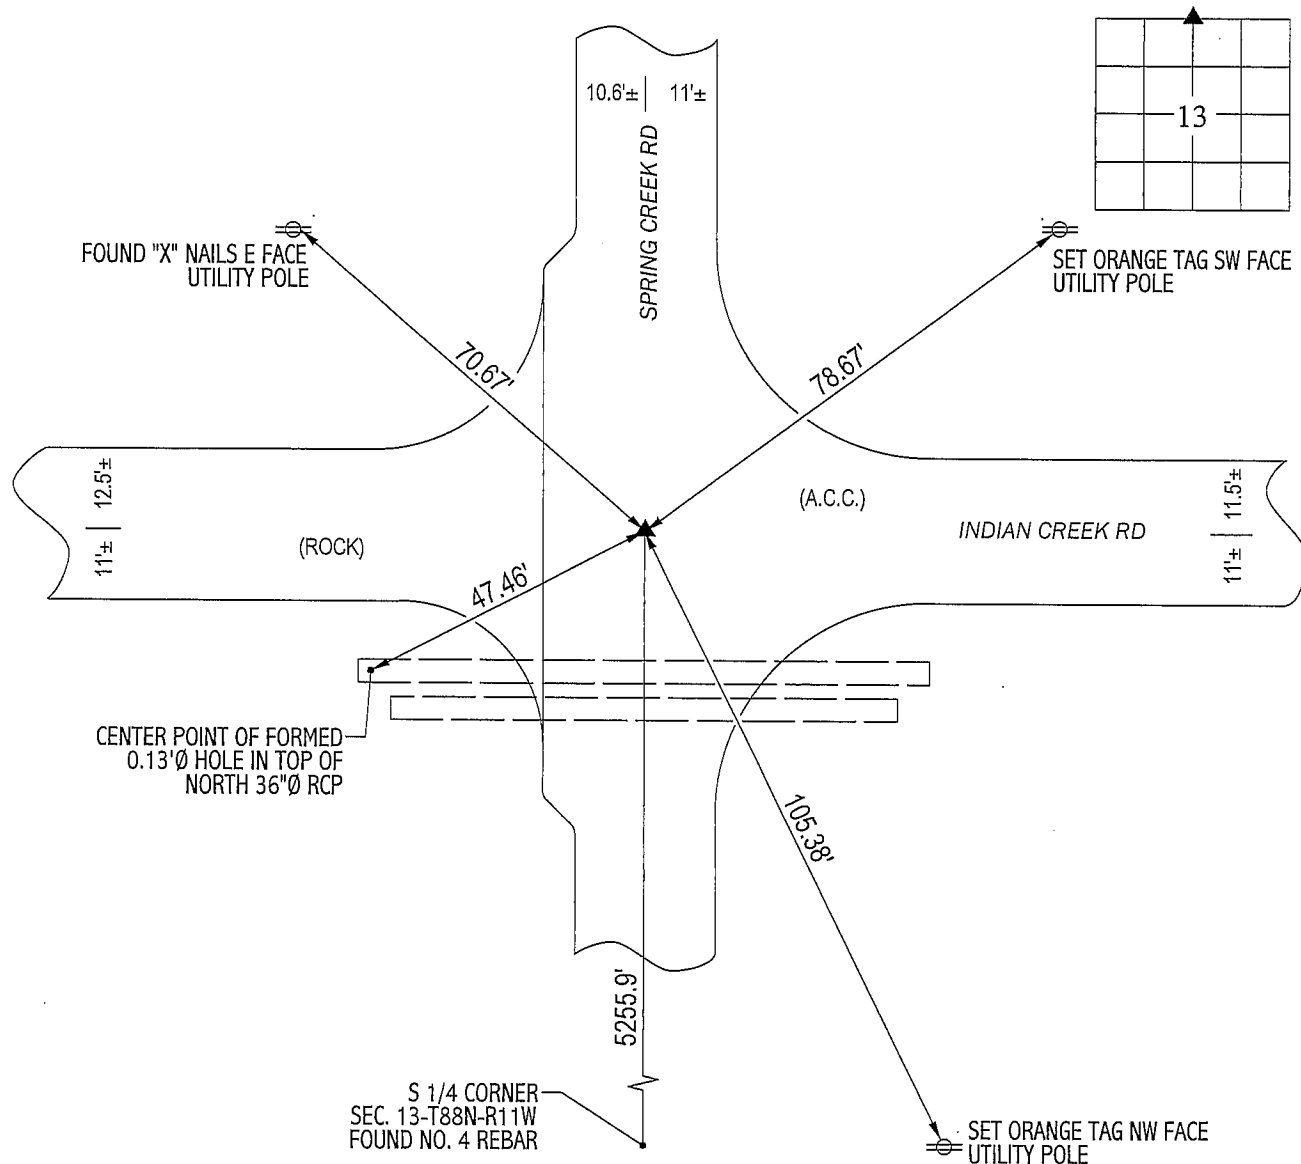

HELLAND ENGINEERING & SURVEYING, LTD.
1107 Technology Parkway
Cedar Falls, Iowa 50613-6951
(319)-266-0161

(00.00') - RECORDED AS

FILE NAME: 02-306C2.DRG

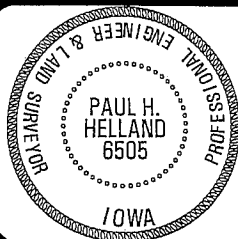

I hereby certify that this land surveying document was prepared and the related survey work was performed by me or under my direct personal supervision and that I am a duly licensed Land Surveyor under the laws of the State of Iowa.

Paul R. Helton 10/31/02

Paul H. Helland

License Number 6505

My license renewal date is December 31, 2003.

All pages or sheets are covered by this seal except:

LIST CORNERS TO BE INDEXED

<u>CORNER</u>	<u>SECTION</u>	<u>TOWNSHIP</u>	<u>RANGE</u>
N 1/4 CORNER	13	88N	11W

N 1/4 CORNER 13 88N 11W

[Handwritten signature]