

Done

UNITED STATES PUBLIC LAND SURVEY CORNER CERTIFICATE

OF

Land Survey Monuments situated in Section 18, Township 88 N, Range 11 W, of the Fifth Principal Meridian, Black Hawk County, Iowa. previously recorded in _____ in County Recorder's Office.





(book, page, document number, etc.)

(Show reason for preparing this certificate, the evidence and detailed procedures used in establishing the corner positions and monumentation found or placed.)

Monument Description and Remarks: No current references on record.

PLAN - VIEW

(Show a minimum of three reference ties to durable physical objects, relevant monuments and physical conditions that will enable recovery of the corner.)

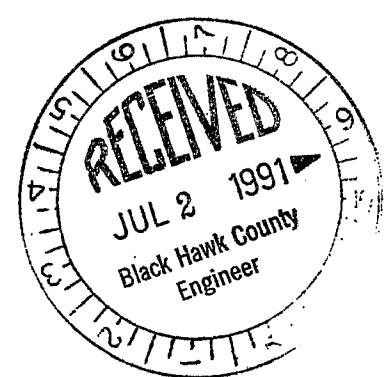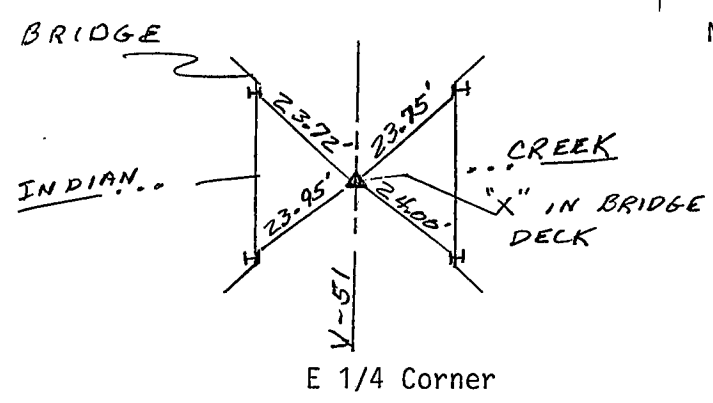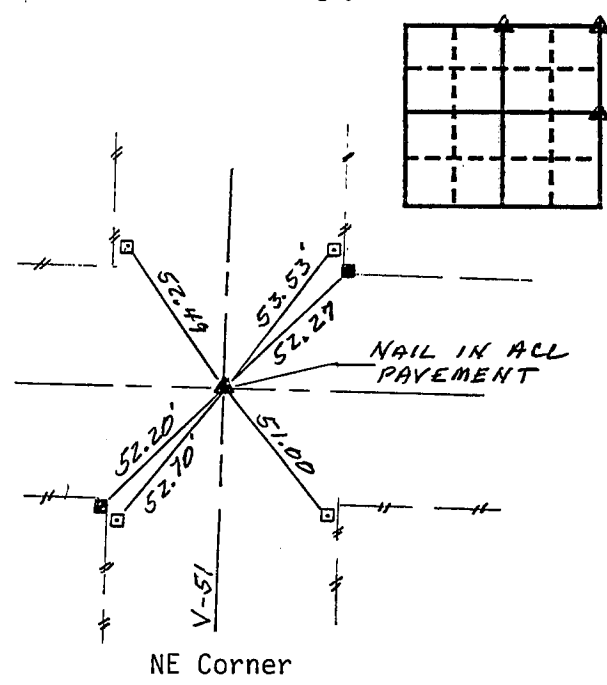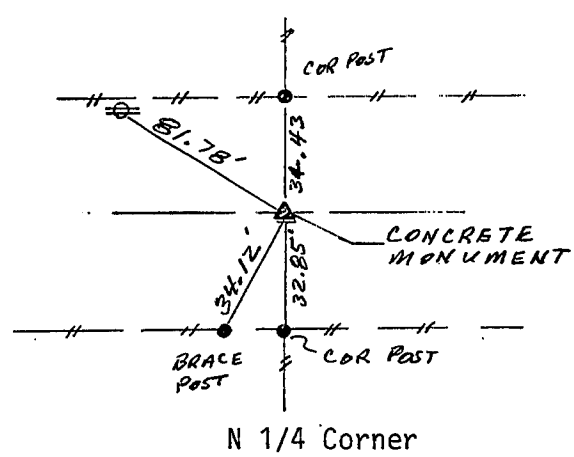

I hereby certify that the survey work was completed and this certificate was prepared by me or under my direct personal supervision and that I am a duly registered land surveyor under the laws of the state of Iowa.

Signature: John R. Crawford
Name typed or printed: John R. Crawford, R.L.S.

Date: April 1, 1991 Reg. No. 7474

Corners	List Corners to be Indexed		
	Section	Twp	Range
N 1/4 Corner	18	88	11
NE Corner	18	88	11
E 1/4 Corner	18	88	11

SEAL

