INDEX BLACK HAWK COUNTY, IOWA:ss FEE BOOK # 20 05 18346

PROOF FILED FOR RECORD FEB 2 2005 AT 10:00 A. M. FEE 1-5.00/ -1.00/

COMPARED Patricia A. Loss BLACK HAWK COUNTY RECORDER

ENV WAYNE CLAASSEN ENGINEERING & SURVEYING, INC.
WAYNE CLAASSEN ENGINEERING AND SURVEYING, INC.
P.O. BOX 898 WATERLOO, IOWA 50704-0898
PHONE: (VOICE) 319-235-6294
(FAX) 319-235-0028

UNITED STATES PUBLIC LAND SURVEY CORNER CERTIFICATE

Land Survey Monuments situated in Section 20, Township 88 North, Range 11 West, of the Fifth Principal Meridian, Black Hawk County, Iowa.

Previously recorded in _____ in County Recorder's Office.
(book, page, document number, etc.)

(Show reason for preparing this certificate, the evidence and detailed procedures used in establishing the corner positions and monumentation found or placed.)

Monument Description and Remarks No certificate on file. Corners used based upon County ties.

PLAN - VIEW

(Show a minimum of three reference ties to durable physical objects, relevant monuments and physical conditions that will enable recovery of the corner.)

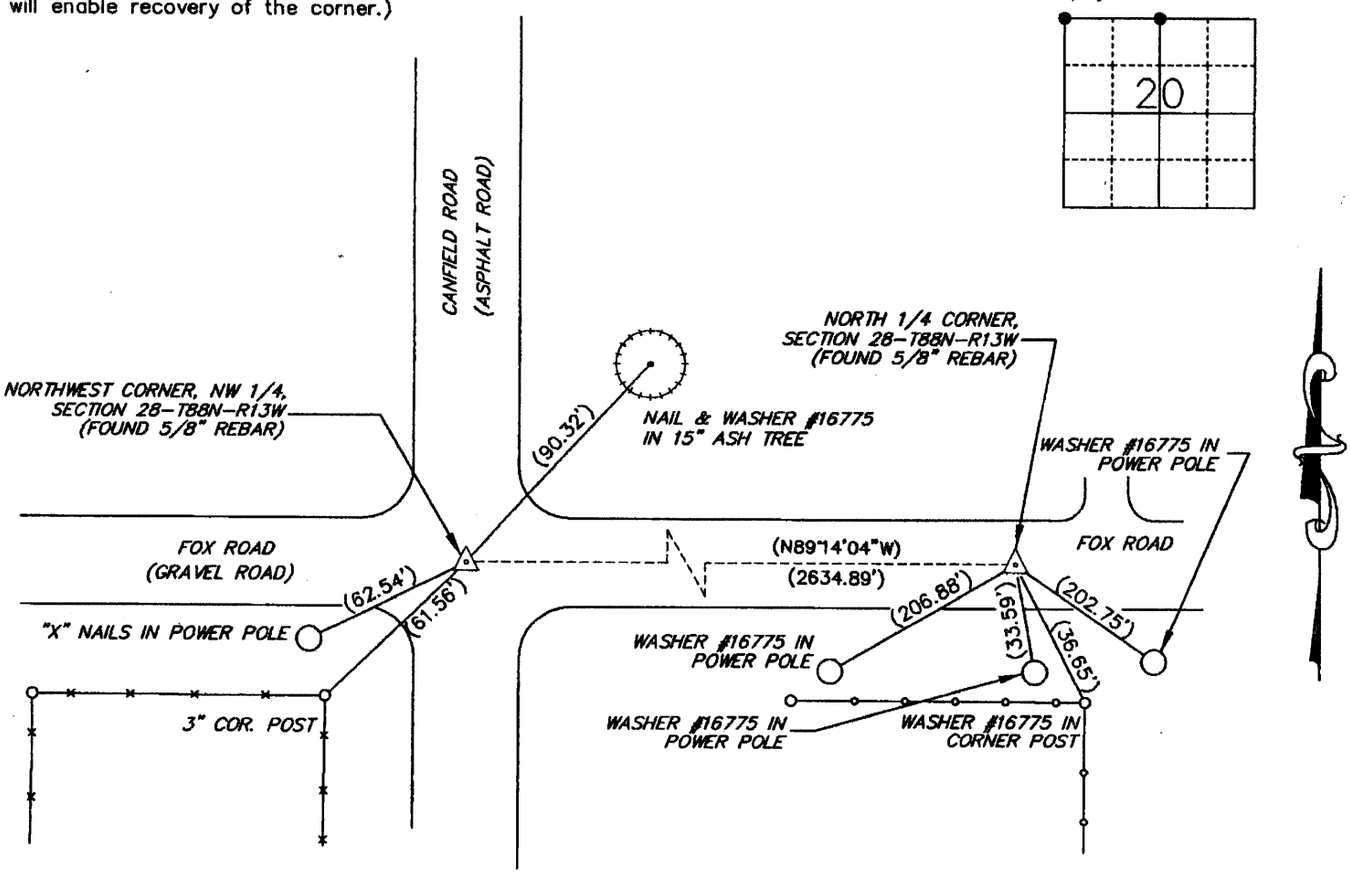

FB. 608, PG. 62

I hereby certify that the survey work was completed and this certificate was prepared by me or under my direct personal supervision and that I am a duly licensed land surveyor under the laws of the state of Iowa.

Signature: David L. Scheil
David L. Scheil, LS.

Date: Jan. 31, 2005 Lic. No. 16775

My license renewal date is December 31, 2006

SEAL

DAVID L. SCHEIL ★ LICENSED 16775 IOWA ★ LAND SURVEYOR

List Corners to be Indexed

Corners	Section	Twp	Range
NORTHWEST COR.,	20	88 N	11 W
NORTH 1/4 COR.,	20	88 N	11 W