

UNITED STATES PUBLIC LAND SURVEY CORNER CERTIFICATE

OF

Land Survey Monuments situated in Section 24, Township 88, Range 11, of the Fifth Principal Meridian, Black Hawk County, Iowa.
Previously recorded in Book _____, Page _____.

(Show reason for preparing this certificate, the evidence and detailed procedures used in establishing the corner positions and monumentation found or placed.)



Monument Description and Remarks: Doing survey in N 1/2 NW 1/4

N 1/4 Cor. Found Nail

NW cor. Found Nail

PLAN - VIEW

(Show a minimum of three reference ties to durable physical objects, relevant monuments and physical conditions that will enable recovery of the corner.)

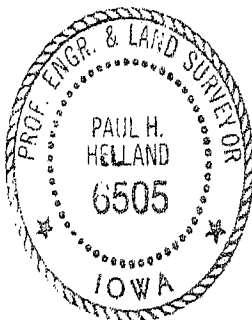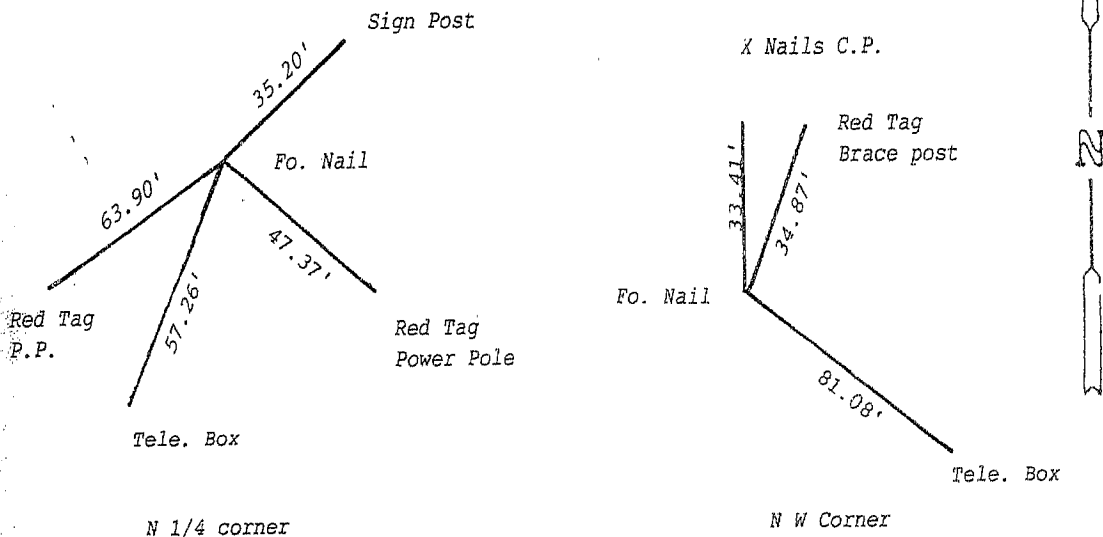

I hereby certify that the survey work was completed and this certificate was prepared by me or under my direct personal supervision and that I am a duly registered land surveyor under the laws of the state of Iowa.

Paul H. Helland 9/26/90
Paul H. Helland
REGISTERED LAND SURVEYOR NO. 6505

SEAL

List Corners to be Indexed

Corners	Section	Twp	Range
N 1/4	24	88	11
N W	24	88	11