

TEKIPPE ENGINEERING PC 128 SOUTH VINE ST WEST UNION IA 52175

TEKIPPE ENGINEERING, P.C., 128 South Vine Street, West Union, Iowa 52175 Phone (563) 422-5131

UNITED STATES PUBLIC LAND SURVEY CORNER CERTIFICATE

OF

Land Survey Monuments situated in Section 26, Township 88 North, Range 11 West of the Fifth Principal Meridian, BLACK HAWK County, Iowa.

Previously recorded in none in County Recorder's Office.
(book, page, document number, etc.)

(Show reason for preparing this certificate, the evidence and detailed procedures used in establishing the corner positions and monumentation found or placed.)


Monument Description and Remarks: N 1/4 Corner Section 26 T88N R11W: Found 1/2"Ø iron pin with information obtained from a Survey and Plat made by Dennis R. Prange, recorded in the Black Hawk County Recorder's Office in Book 259, Page 102.

SW Corner Section 26 T88N R11W: Found concrete monument with 1/2"Ø iron pin at surface with information obtained from the Black Hawk County Engineer's Office on Page 30 of Field Book 10 for Township 88, Range 11.

PLAN - VIEW


268811cu.dwg Project Number 02088.LS
FB. 52B PG. 1-2

(Show a minimum of three reference ties to durable physical objects, relevant monuments and physical conditions that will enable recovery of the corner.)

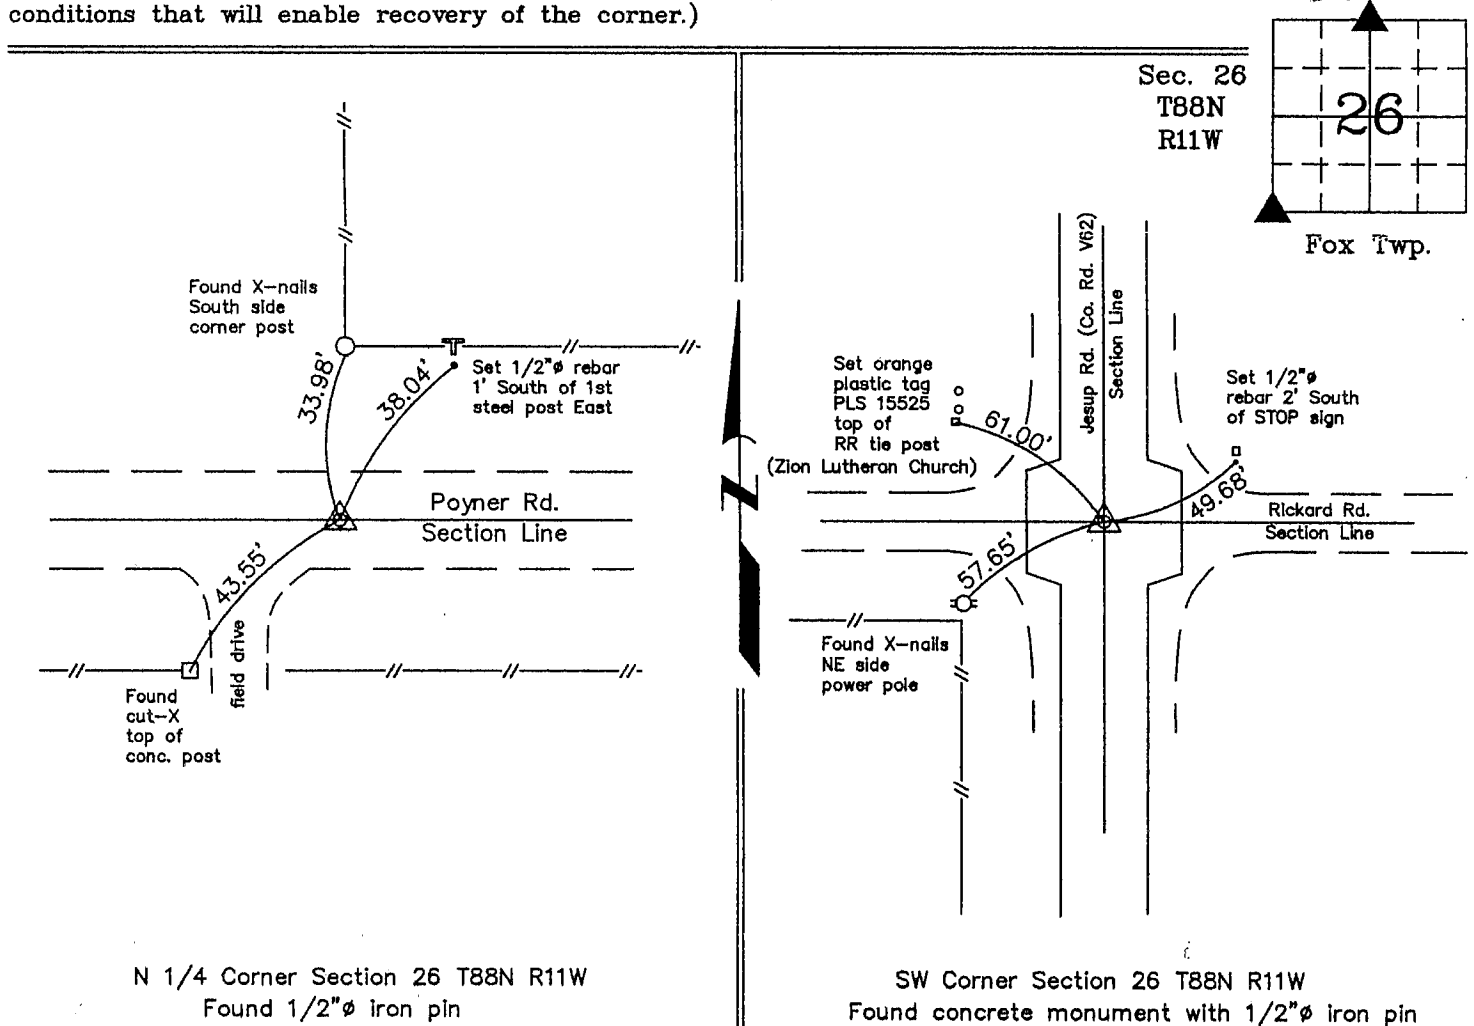

N 1/4 Corner Section 26 T88N R11W
Found 1/2"Ø Iron pin

SW Corner Section 26 T88N R11W
Found concrete monument with 1/2"Ø iron pin

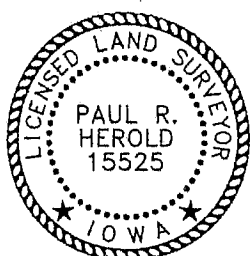

I hereby certify that this land surveying document was prepared and the related survey work was performed by me or under my direct personal supervision and that I am a duly licensed Land Surveyor under the laws of the State of Iowa.

Paul R. Herold 5-2-02
Paul R. Herold Date
License number 15525
My license renewal date is December 31, 2002.
Sheets covered by this seal: Individual

List Corners to be Indexed			
Corners	Section	Twp.	Range
N 1/4	26	88N	11W
SW	26	88N	11W