HELLAND ENGINEERING & SURVEYING

IЦ

Document Number: 2009000532

Aud Fee:

0.00

Date: Jul 08, 2008 4:30:00 pm Rec Fee:

Trans Tax: E-Com Fee:

0.00 1.00

Rec Management Fee: Non-Standard Page Fee:

5.00


1.00 0.00

 \mathbf{Z}

Filed for record in Black Hawk County, Iowa

Judith A. McCarthy, County Recorder

Jeffrey P. Helland, 1107 Technology Parkway, Cedar Falls, lowa 50613-6951, (319)-266-0161

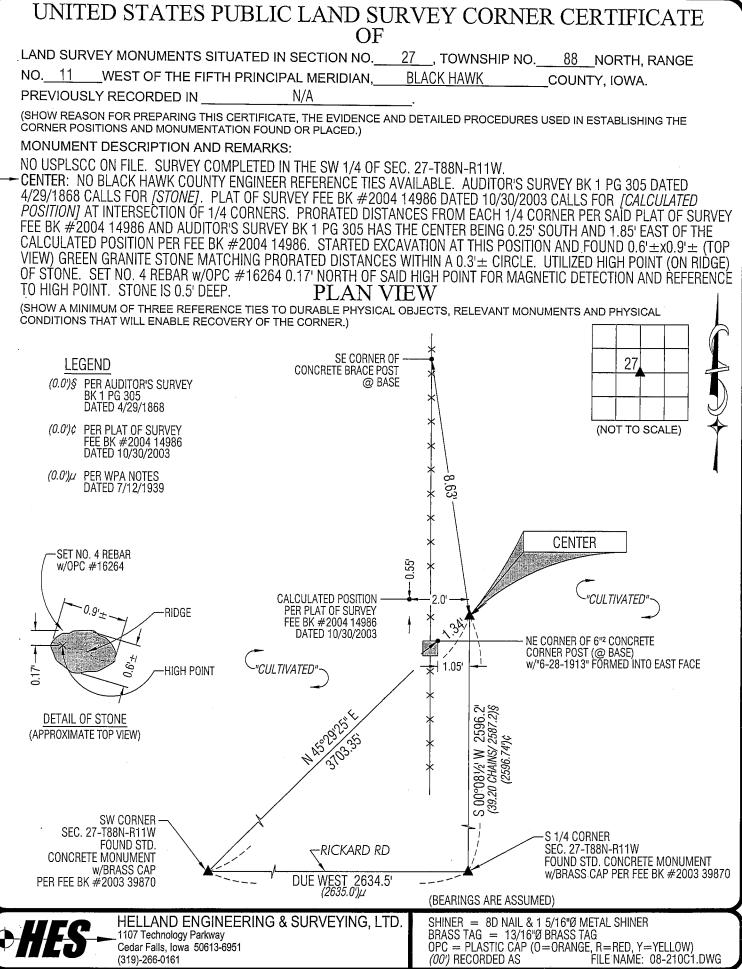

6/17/08

HELLAND

4 w 0 \

1107 Technology Parkway Cedar Falls, Iowa 50613-6951

I hereby certify that this land surveying document was prepared and the related survey work was performed by me or under my direct personal supervision and that I am a duly licensed Land Surveyor under the laws of the State of lowa.

Jeffrey F. Velland
License Number 16264
My license renewal date is December 31, 2009.
All pages or sheets are covered by this seal except:

LIST CORNERS TO BE INDEXED

CORNER SECTION TOWNSHIP **RANGE** 27 CENTER 88N 11W