

BLACK HAWK COUNTY ENGINEER

PREPARED BY: BLACK HAWK COUNTY ENGINEERS OFFICE
316 E. FIFTH STREET, ROOM 211 WATERLOO, IOWA 50703PH.# (319) 833-3008
FAX.# (319) 833-3139SLSI 9-94
CERT 12-96

UNITED STATES PUBLIC LAND SURVEY CORNER CERTIFICATE OF
Land Survey Monuments situated in Section 27, Township 88 N,
Range 11 W, of the Fifth Principal Meridian, BLACK HAWK County, Iowa.
Previously recorded in Misc. Book 321, Page 581, in County Recorder's Office.

(Show reason for preparing this certificate, the evidence and detailed procedures used in establishing the corner positions and monumentation found or placed.)

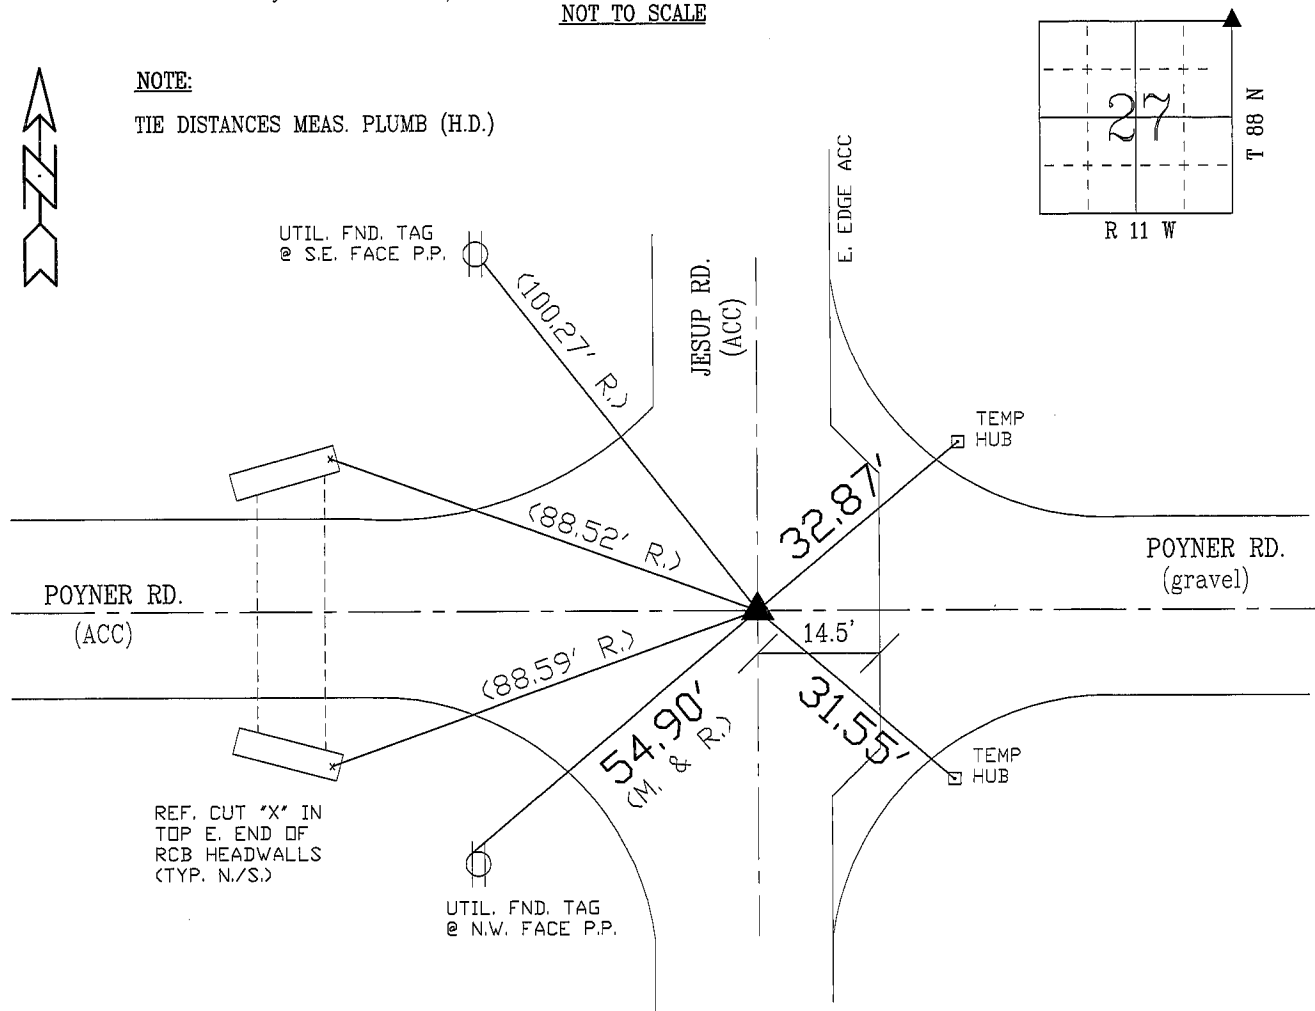
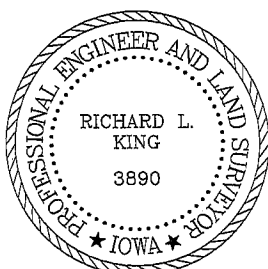
Monument Description and Remarks: FOUND #4 RBR IN CL. ACC PRIOR TO
RESURF. PROJECT, PER RECORD TIES. TEMP. REF. CORNER, & CONSTR. NEW
4.5" ACC MAT OVERLAY. RESET #5 REBAR AS DENOTED, WITH RE-SET
CPRMER LOCATED 0.25' EAST OF C.L. ACC PAVING JOINT.

PLAN - VIEW

(Show a minimum of three reference ties to durable physical objects, relevant monuments and physical conditions that will enable recovery of the corner.)

NOT TO SCALENOTE:

TIE DISTANCES MEAS. PLUMB (H.D.)

FIELD SURVEY: G.T. & C.W. 10/10/2005
PREPARED BY: G. TINKER 11/1/2005CERTIFICATION

I hereby certify that this land surveying document was prepared and the related survey work was performed by me or under my direct personal supervision and that I am a duly licensed Land Surveyor under the laws of the State of Iowa.

Richard L. King 11/16/05
Richard L. King (date)

License Number 3890

My license renewal date is December 31, 2005

Pages or sheets covered by this seal:

This Land Corner Certificate Only.

LIST CORNERS TO BE INDEXED

Corner	Section	Township	Range
N.E. COR.	27	88 N	11 W
N.W. COR.	26	88 N	11 W
S.E. COR.	22	88 N	11 W
S.W. COR.	23	88 N	11 W