


PROOF FILED FOR RECORD DEC 10 2004 AT 4:00 P. M. FEE 1-5.00-1.00/

COMPARED

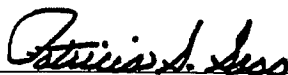

BLACK HAWK COUNTY RECORDER

ENV KESS &amp; ASSOCIATES


Kirk D. Eschliman, P.L.S. Iowa Lic. No. 9961, 723 Broadway Street, Waterloo, Iowa 50703 - Phone: 319-234-0509

UNITED STATES PUBLIC LAND SURVEY CORNER CERTIFICATE  
OFLAND SURVEY MONUMENTS SITUATED IN SECTION 29, TOWNSHIP 88 NORTH  
RANGE 11 WEST, OF THE FIFTH PRINCIPAL MERIDIAN, BLACK HAWK COUNTY, IOWA.  
PREVIOUSLY RECORDED IN (BOOK, PAGE, DOCUMENT NUMBER, ETC.) IN THE COUNTY RECORDER'S OFFICE.(SHOW REASON FOR PREPARING THIS CERTIFICATE, THE EVIDENCE AND DETAILED PROCEDURES USED IN ESTABLISHING THE CORNER POSITIONS AND MONUMENTATION FOUND OR PLACED.)  
MONUMENT DESCRIPTION AND REMARKS: FOUND 5/8" IRON PIN WITHOUT ID CAP IN A.C.C. PAVEMENTMEASUREMENTS TO FENCE  
POSTS ARE TO THE FACE  
OF THE FENCE POSTSSE 1/4  
SECTION 20  
T88N R11W

PLAN

VIEW

GRAPHIC SCALE

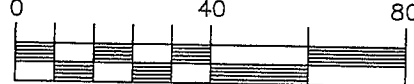

(in feet)

1 Inch = 40 Ft.

SW 1/4  
SECTION 21  
T88N R11W

NO FENCES

NO FENCES

POYNER ROAD  
A.C.C. SURFACE11.0' EDGE OF ASPHALT  
10.7' EDGE OF ASPHALTPOWER POLE WITH  
"X" NAILSPOWER POLE WITH  
"X" NAILS

WIRE FENCE

CONCRETE END  
POST

POWER LINES

NO FENCES

NE 1/4  
SECTION 29  
T88N R11WNW 1/4  
SECTION 28  
T88N R11WI HEREBY CERTIFY THAT THIS LAND SURVEYING DOCUMENT  
WAS PREPARED AND RELATED SURVEY WORK WAS  
PERFORMED BY ME OR UNDER MY DIRECT PERSONAL  
SUPERVISION AND THAT I AM A DULY LICENSED LAND  
SURVEYOR UNDER THE LAWS OF THE STATE OF IOWA.


DATE: 10/20/2003

KIRK D. ESCHLIMAN, P.L.S. IOWA LIC. NO. 9961  
MY LICENSE RENEWAL DATE IS DECEMBER 31, 2003  
PAGES OR SHEETS COVERED BY THIS SIGNATURE & SEAL: SHEET 1 OF 1FOR: JERRY & CHERYL SCHMITZ  
9406 RICKARD ROAD  
JESUP, IOWA 50648REQ. BY: JERRY SCHMITZ  
JESUP, IOWAKESS & ASSOCIATES, INC.  
PROFESSIONAL LAND SURVEYORS : 723 BROADWAY, WATERLOO, IOWA 50703-5811  
DATE: 10/20/2003 C.A.D.D. FILE: 03A83CC4.DWG PROJECT NO.: 03A83

## List of corners to be indexed:

Corners	Section	Township	Range
NE COR	29	T88N	R11W

## SECTION 29

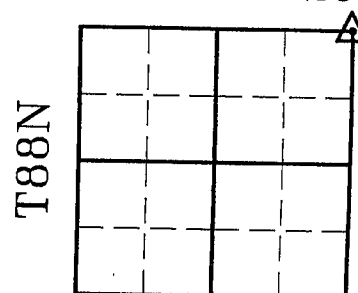

R11W