

SC ✓
MISC ✓
INDEX ✓
MARGIN ✓
PROOF
COMPARE

FILED FOR RECORD Feb 9, 2000 AT 4:00 P.M., AND RECORDED IN BOOK 337
OF MISC PAGE 164
Patricia A. Hess RECORDER
FEE 1-5.00/
PAUL HELLAND

Paul H. Helland, 1107 Technology Parkway, Cedar Falls, Iowa 50613-6951, (319)-266-0161

UNITED STATES PUBLIC LAND SURVEY CORNER CERTIFICATE
OF

LAND SURVEY MONUMENTS SITUATED IN SECTION NO. 29, TOWNSHIP NO. 88 NORTH, RANGE NO. 11 WEST OF THE FIFTH PRINCIPAL MERIDIAN, BLACK HAWK COUNTY, IOWA.

PREVIOUSLY RECORDED IN BOOK, PAGE.

(SHOW REASON FOR PREPARING THIS CERTIFICATE, THE EVIDENCE AND DETAILED PROCEDURES USED IN ESTABLISHING THE CORNER POSITIONS AND MONUMENTATION FOUND OR PLACED.)

MONUMENT DESCRIPTION AND REMARKS:


SURVEY DONE IN E 1/2 SW 1/4 OF SEC. 29-T88N-R11W.

W 1/4 CORNER: Found 0.2'Ø IDOT Marker in P.C.C. Bridge Deck.

CENTER: Land Corner Survey by IDOT (file #3025) calls for a granite stone, found granite stone w/point from reference ties. Set No. 4 rebar w/orange cap #6505 for magnetic detection & reference 0.18' West of point on stone. Stone & rebar approximately 0.6' deep.

PLAN VIEW

(SHOW A MINIMUM OF THREE REFERENCE TIES TO DURABLE PHYSICAL OBJECTS, RELEVANT MONUMENTS AND PHYSICAL CONDITIONS THAT WILL ENABLE RECOVERY OF THE CORNER.)

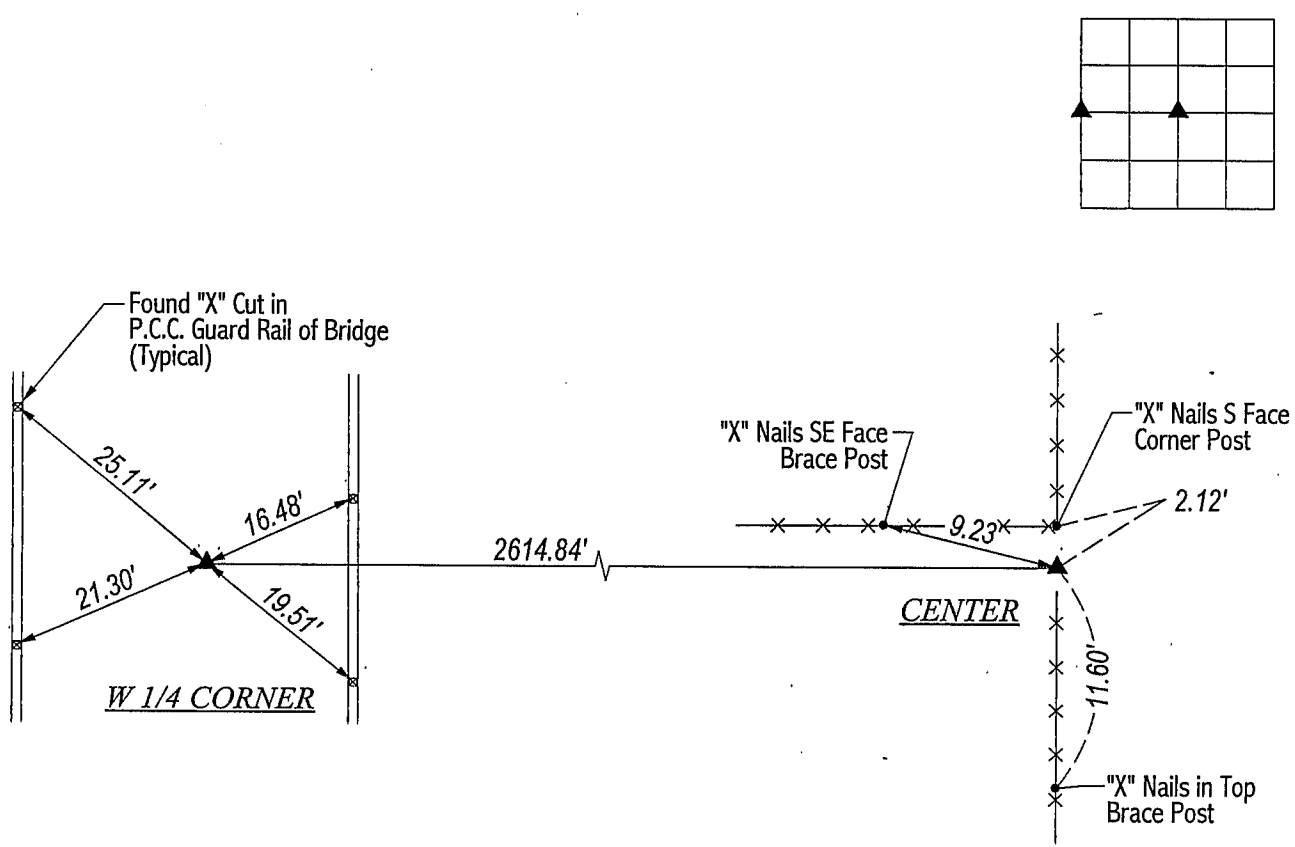

HES HELLAND ENGINEERING & SURVEYING, LTD.
1107 Technology Parkway
Cedar Falls, Iowa 50613-6951
(319)-266-0161

FILE NAME: 00-113CC.DRG



I hereby certify that this land surveying document was prepared and the related survey work was performed by me or under my direct personal supervision and that I am a duly licensed Land Surveyor under the laws of the State of Iowa.
Paul H. Helland 2/8/00
Paul H. Helland
License Number 6505
My license renewal date is December 31, 2001.
All pages or sheets are covered by this seal except:

| LIST CORNERS TO BE INDEXED | | | |
|----------------------------|---------|----------|-------|
| CORNER | SECTION | TOWNSHIP | RANGE |
| W 1/4 CORNER | 29 | 88N | 11W |
| CENTER | 29 | 88N | 11W |