


Doc ID: 004586370001 Type: GEN Kind: CORNER Recorded: 09/26/2011 at 02:18:49 PM Fee Amt: \$0.00 Page 1 of 1 Black Hawk County Iowa JUDITH A MCCARTHY RECORDER

## File 2012-00005426

\*BLACK HAWK COUNTY ENGINEERS OFFICE PH.# (319) 833-3008 FAX.# (319) 833-3139 PREPARED BY: SLSI 9-94 BHCO 03-09 316 E. FIFTH STREET, ROOM 211 WATERLOO, IOWA 50703 UNITED STATES PUBLIC LAND SURVEY CORNER CERTIFICATE OF 30 Land Survey Monuments situated in Section\_ <u>11 W</u>, of the Fifth Principal Meridian, <u>BLACK HAWK</u> County, Iowa. Previously recorded in FEE Book 2005, Page 14331, in County Recorder's Office. (Show reason for preparing this certificate): The corner monument has been Replaced or Modified, per la. Code 355.11(1)(c) (Evidence and detailed procedures used in establishing the corner position(s) and monumentation found or placed.) Monument Description and Remarks: N.E. CURNER: CURNER RESET FOR COLD-IN-PLACE RECYL. & H.M.A. RESURE RECYLL & H.M.A. RESURF. PRIOR TO RESURF, PROJECT, FOUND 1/2" REBAR vs. 5/8" IRON PIN PER CURRENT RECORD, TEMP, REF, COR, LOC, PER RTK GPS. AFTER 4" DP. MILL (RECYCLE), FAINT SOUNDING REMAINS @ RTK REF. LOCATION, WITH NO FURTHER EXCAVATION. SOUNDING WAS ALSO PRESENT @ ±1' EAST OF COR. LOCATION, & EXCAVATED TO ±9" DEEP TO FOUND PAVING NAIL W/STRING LINE N-S (REMOVED) W/ ADDITIONAL SOUNDING ALSO REMAINS @ STRING LINE LOC, FOUND, RESET CORNER w/ 5/8" (#5) x 6"L, REBAR LOC, @ ±0.40' EAST OF N-S C.L. H.M.A. JNT. AND ALIGNED w/C.L. SIDEROAD INTERSECTION E-W. DELF. (CORNER) ANGLE DENOTED FOR SECTION LINE TO N./S. PER COGO OF RTK GPS MEAS. CORNERS (AS OBSERVED).

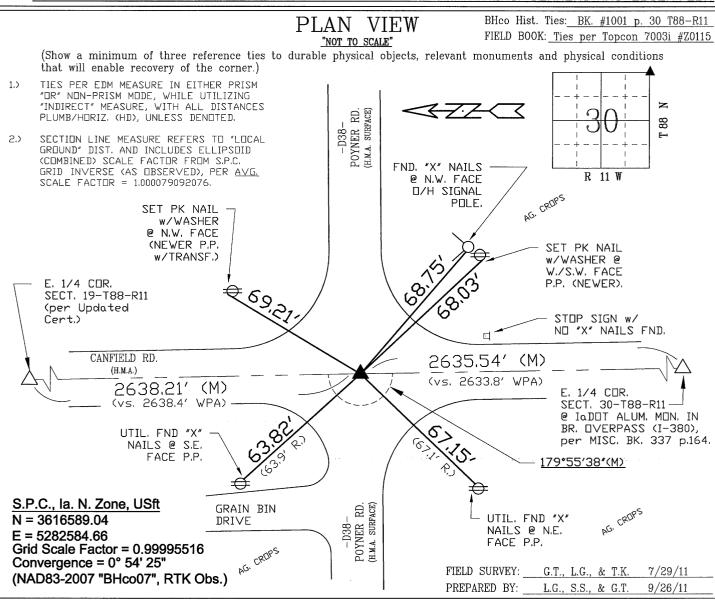



I hereby certify that this land surveying document was prepared and the related survey work was performed by me or under my direct personal supervision and that I am a duly licensed Land Surveyor under the laws of the State of Iowa.

9/26/2011

15748 License Number\_

CERTIFICATION

2012 My license renewal date is December 31,

Pages or sheets covered by this seal:

This Land Corner Certificate Only

LIST	CORNERS '	O BE I	NDEXED	
<u>Corner</u>	<u>Section</u> -	Town	<u>ıship</u> –	<u>Range</u>
N.E. Cor.	30	88	N	11 W
N.W. Cor.	29	88	N	11 W
S.E. Cor.	19	88	N	11 W
S.W. Cor.	20	88	N	11 W
INDEX OF ABBREVIATIONS				
(M) = "Measured" Dimension "NP" = Reflectorless EDM Meas.				
(P) = "Platted" Dimension "MLM" = Indirect Measure				
(R) = "Record" Dimension "CM" = Concrete Monument				

"SM" = Survey Marker Spike/Tag
"PK" = PK/MAG Nail Brand Style

