

Also see Fee Bk: 2007024505


Document Number: 2007024452  
Date: May 18, 2007 4:30:00 pm  
Aud Fee: 0.00 Rec Fee: 5.00  
Trans Tax: 0.00 Rec Management Fee: 1.00  
E-Com Fee: 1.00 Non-Standard Page Fee: 0.00  
Filed for record in Black Hawk County, Iowa  
Judith A. McCarthy, County Recorder

Kirk D. Eschliman, P.L.S. Iowa Lic. No. 9961, 723 Broadway Street, Waterloo, Iowa 50703 - Phone: 319-234-0509

UNITED STATES PUBLIC LAND SURVEY CORNER CERTIFICATE OF  
LAND SURVEY MONUMENTS SITUATED IN SECTION 31, TOWNSHIP 88 NORTH, RANGE 11 WEST, OF THE FIFTH PRINCIPAL  
MERIDIAN, BLACK HAWK COUNTY, IOWA. NOT PREVIOUSLY RECORDED.

(SHOW REASON FOR PREPARING THIS CERTIFICATE, THE EVIDENCE AND DETAILED PROCEDURES USED IN ESTABLISHING THE CORNER POSITIONS AND  
MONUMENTATION FOUND OR PLACED.)

MONUMENT DESCRIPTION AND REMARKS: NO CURRENT SECTION CORNER CERTIFICATE ON FILE IN THE BLACK HAWK  
COUNTY RECORDER'S OFFICE. FOUND NO. 5 REBAR, 1.0 INCHES BELOW SURFACE OF A.C.C. PAVEMENT ROADWAY.  
MONUMENT USED FOR SURVEY IN SW 1/4 OF SECTION 32.

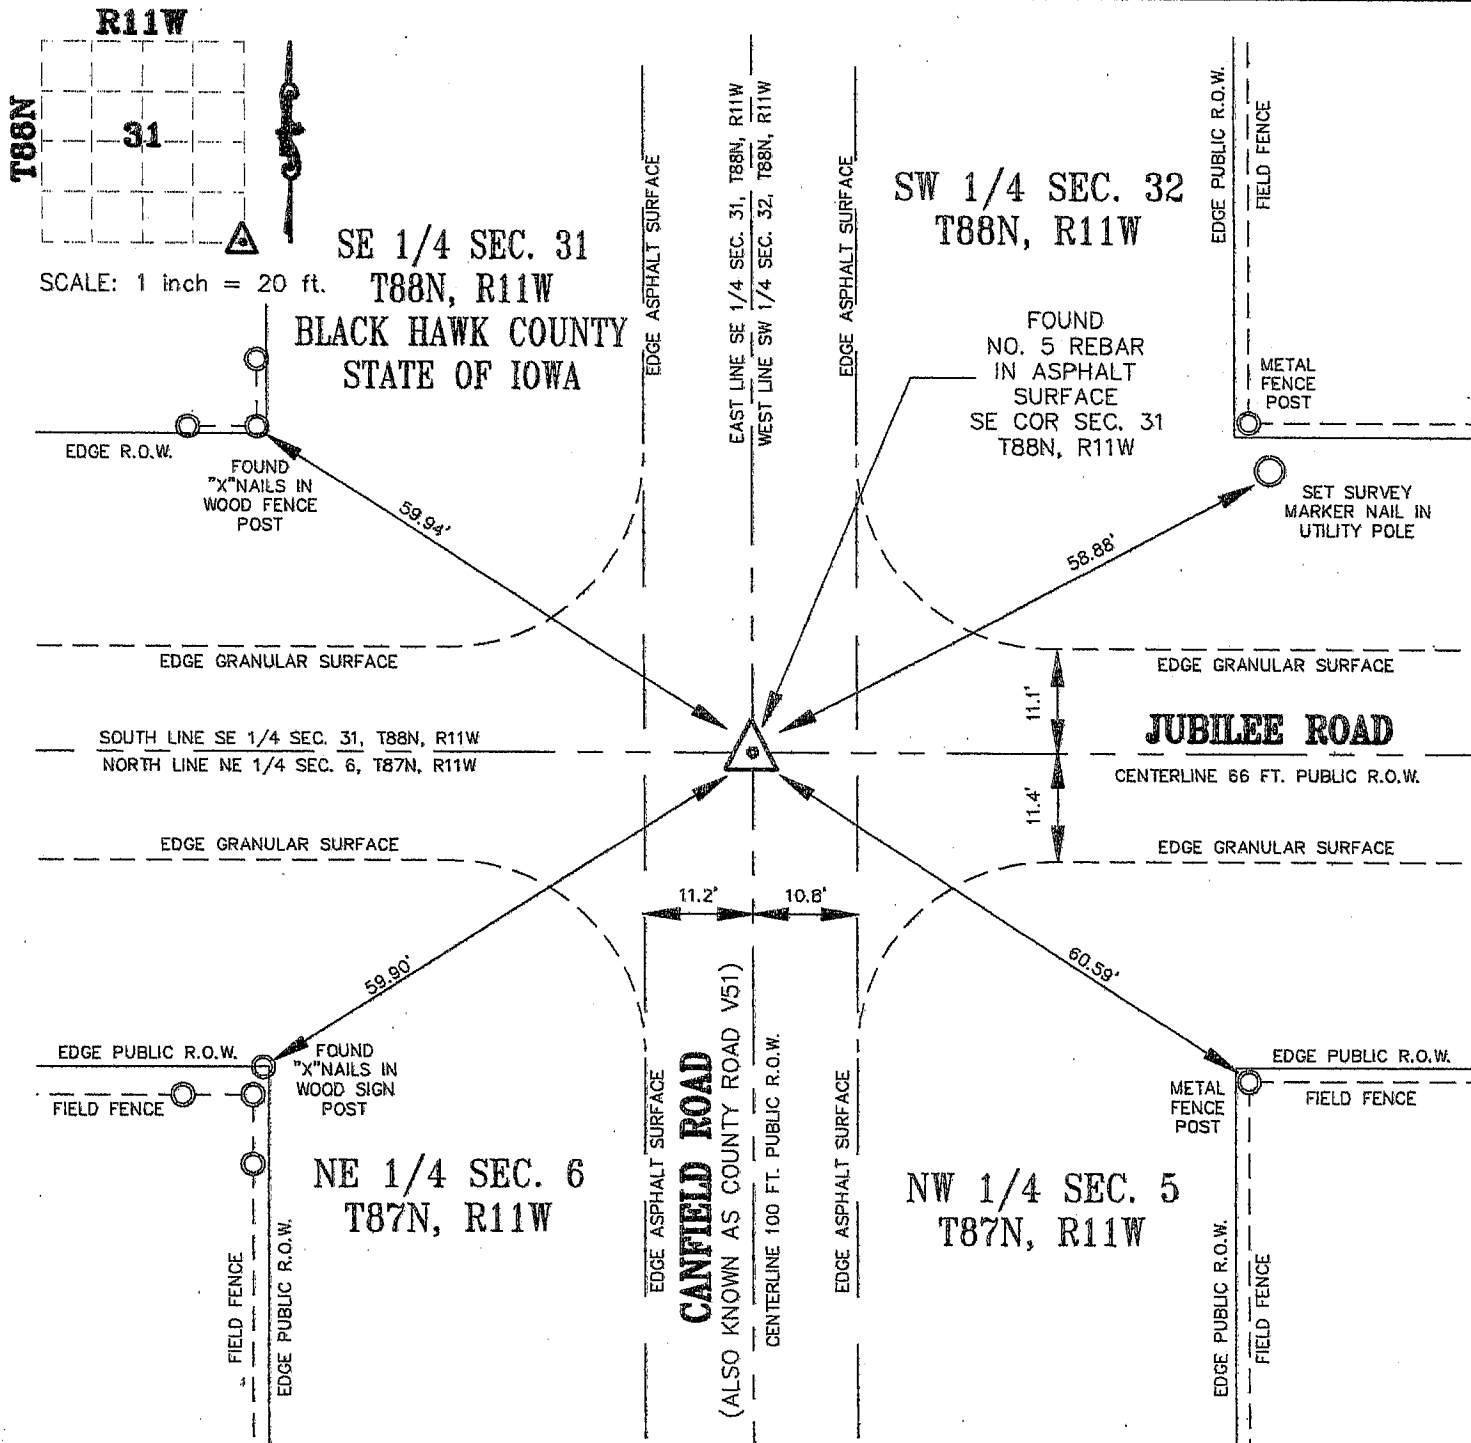

I HEREBY CERTIFY THAT THIS LAND SURVEYING DOCUMENT  
WAS PREPARED AND THE RELATED SURVEY WORK WAS  
PERFORMED BY ME OR UNDER MY DIRECT PERSONAL  
SUPERVISION AND THAT I AM A DULY LICENSED LAND  
SURVEYOR UNDER THE LAWS OF THE STATE OF IOWA.

*Kirk D. Eschliman*  
KIRK D. ESCHLIMAN, P.L.S. IOWA LIC. NO. 9961  
MY LICENSE RENEWAL DATE IS DECEMBER 31, 2007  
PAGES OR SHEETS COVERED BY THIS SIGNATURE & SEAL: SHEET 1 OF 1



LIST OF CORNERS TO BE INDEXED:

CORNER	SEC	TWP	RANGE
SE COR.	31	88	11

KESS & ASSOCIATES, INC.  
723 BROADWAY, WATERLOO, IOWA 50703-5811 PHONE: (319) 234-0509

DATE OF FIELD WORK: MAY 14, 2007  
DWG. DATE: 05/15/2007  
CADD FILE: 04B74SCC1.DWG  
DRAWN BY: BJYK  
PROJECT NO.: 04B74