

UNITED STATES PUBLIC LAND SURVEY CORNER CERTIFICATE

OF


Land Survey Monuments situated in Section 33, Township 88 NORTH, Range 11 WEST, of the Fifth Principal Meridian, BLACK HAWK County, Iowa.
Previously recorded in SEE NOTE BELOW in County Recorder's Office.
(book, page, document number, etc.)

(Show reason for preparing this certificate, the evidence and detailed procedures used in establishing the corner positions and monumentation found or placed.)

Monument Description and Remarks: Previous Reference ties from Plot 3085
Land Corner Survey Black Hawk County Project No. 1-380-7(16)-01-07,
Project No. 1-380-7(19)-01-07, T88N, R11W. Made for Iowa D.O.T.
by Robert Burns R.L.S. 6705. Center Section 33-88-11, Found
concrete monument 15" deep. Set iron pin over. South 1/4 corner section 33-
11-88. Found concrete monument 18" deep. Set iron pin over.

PLAN - VIEW

(Show a minimum of three reference ties to durable physical objects, relevant monuments and physical conditions that will enable recovery of the corner.)

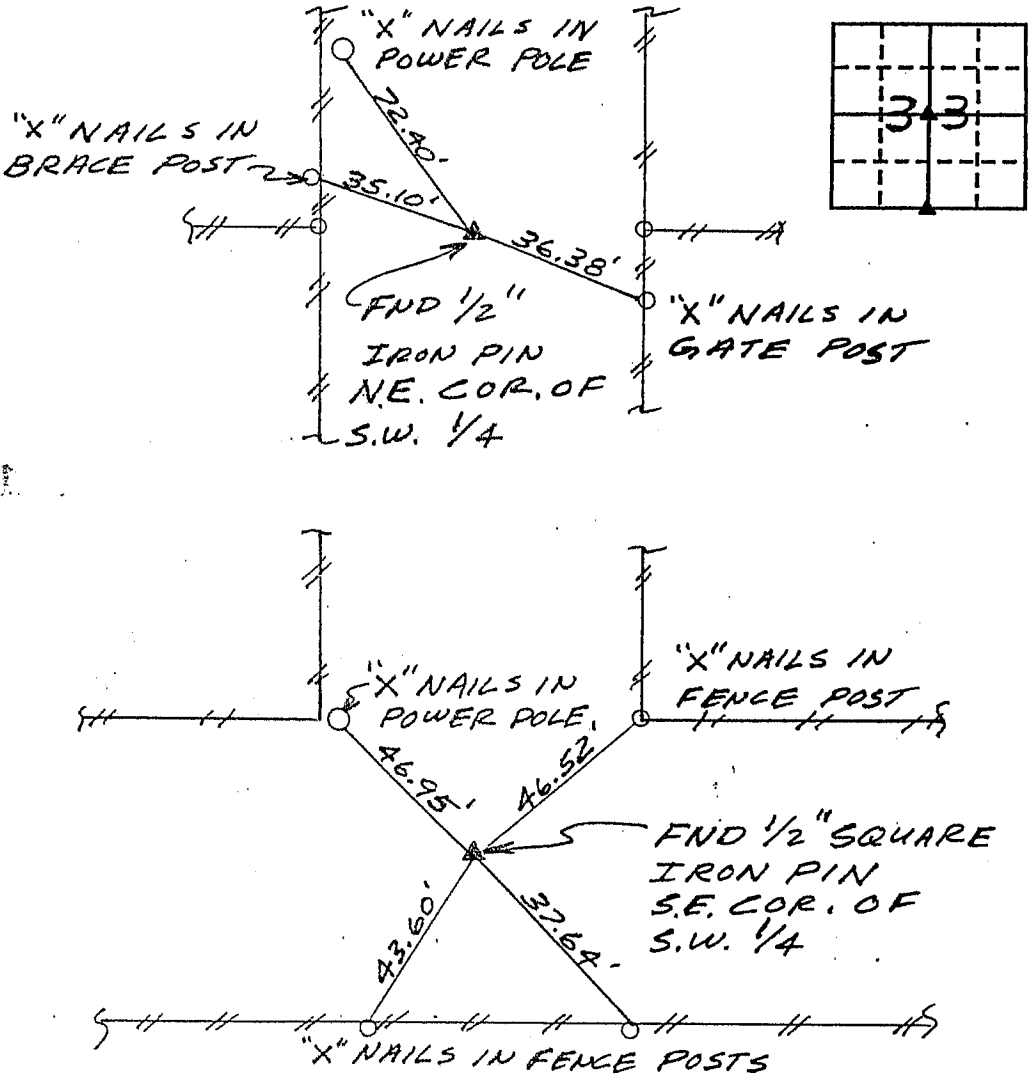


I hereby certify that the survey work was completed and this land surveying document was prepared by me or under my direct personal supervision and that I am a duly registered land surveyor under the laws of the state of Iowa

Signature: Myron Schube
Name typed or printed: Myron Schube

Date: 10-15-98 Reg. No. 8807

My registration renewal date is December 31, 1999

SEAL

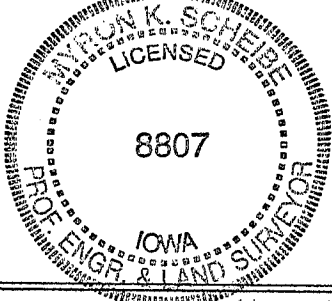

Corners	List Corners to be Indexed		
	Section	Twp	Range
N.E. COR. OF S.W. 1/4	33	88N	11W
S.E. COR. OF S.W. 1/4	33	88N	11W