
Doc ID: 004190370001 Type: GEN Kind: CORNER Recorded: 07/06/2010 at 10:52:17 AM Fee Amt: \$9.00 Page 1 of 1 Black Hawk County Iowa JUDITH A MCCARTHY RECORDER

File 2011-00000233

Jeffrey P. Helland, 1107 Technology Parkway, Cedar Falls, lowa 50613-6951, (319)-266-0161

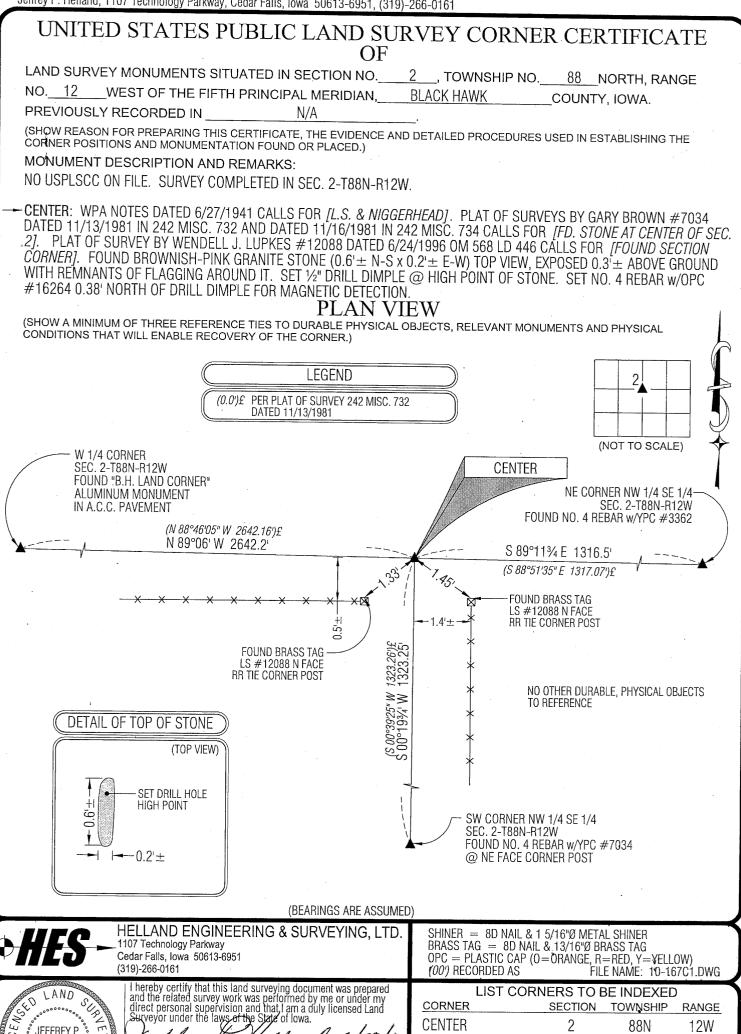

JEFFREY P

HELLAND 16264

10WA

Jeffrey P Helland License Number 16264

My license renewal date is December 31, 2011. All pages or sheets are covered by this seal except:

12W