004190350001 Type: GEN

Doc ID: 004190350001 Type: GEN
Kind: CORNER
Recorded: 07/06/2010 at 10:52:04 AM
Fee Amt: \$9.00 Page 1 of 1
Black Hawk County Iowa
JUDITH A MCCARTHY RECORDER

File 2011-00000231

Jeffrey P. Helland, 1107 Technology Parkway, Cedar Falls, Iowa 50613-6951, (319)-266-0161

UNITED STATES PUBLIC LAND SURVEY CORNER CERTIFICATE OF , TOWNSHIP NO. LAND SURVEY MONUMENTS SITUATED IN SECTION NO. NORTH, RANGE

88

WEST OF THE FIFTH PRINCIPAL MERIDIAN, 12 **BLACK HAWK** COUNTY, IOWA.

PREVIOUSLY RECORDED IN

(SHOW REASON FOR PREPARING THIS CERTIFICATE, THE EVIDENCE AND DETAILED PROCEDURES USED IN ESTABLISHING THE CORNER POSITIONS AND MONUMENTATION FOUND OR PLACED.)


MONUMENT DESCRIPTION AND REMARKS:

NO USPLSCC ON FILE. SURVEY COMPLETED IN SEC. 2-T88N-R12W.

NE CORNER SE 1/4 SW 1/4: PLAT OF SURVEYS BY GARY BROWN #7034 DATED 11/13/1981 IN 242 MISC, 732 AND DATED 11/16/1981 IN 242 MISC. 734 CALLS FOR [1/2" REBAR WITH PLASTIC REGISTRATION CAP SET]. FOUND NO. 4 REBAR W/YPC #7034 @ NE FACE CORNER POST.

PLAN VIEW

(SHOW A MINIMUM OF THREE REFERENCE TIES TO DURABLE PHYSICAL OBJECTS, RELEVANT MONUMENTS AND PHYSICAL CONDITIONS THAT WILL ENABLE RECOVERY OF THE CORNER.)

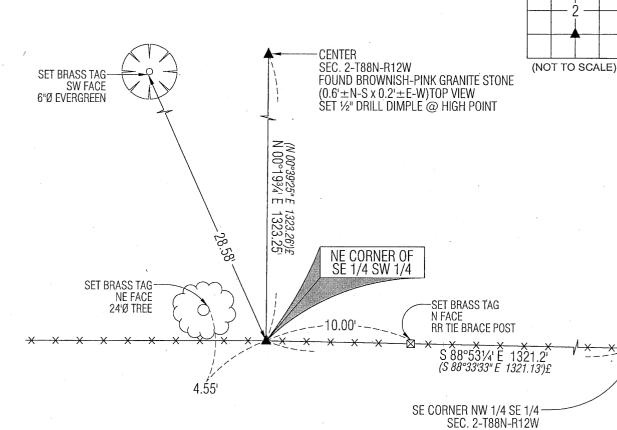

LEGEND

PER PLAT OF SURVEY 242 MISC. 732 (0.0')£ DATED 11/13/1981

(BEARINGS ARE ASSUMED)

FOUND NO. 4 REBAR w/YPC #7034



LAND

16264

4W01

HELLAND ENGINEERING & SURVEYING, LTD.

1107 Technology Parkway Cedar Falls, Iowa 50613-6951 (319)-266-0161

JEFFREY P HELLAND

I hereby certify that this land surveying document was prepared and the related survey work was performed by me or under my direct personal supervision and that I am a duly licensed Land Surveyor under the laws of the State of lowa.

reffrey P. Helland License Number 16264

My license renewal date is December 31, 2011. All pages or sheets are covered by this seal except:

SHINER = 8D NAIL & 1 5/16"Ø METAL SHINER BRASS TAG = 8D NAIL & 13/16"Ø BRASS TAG OPC = PLASTIC CAP (O=ORANGE, R=RED, Y=YELLOW) (00') RECORDED AS FILE NAME: 10-167G3.DWG

LIST CORNERS TO BE INDEXED			
CORNER	SECTION	TOWNSHIP	RANGE
NE COR. SE 1/4 SW 1/4	2	88N	12W
SE COR. NE 1/4 SW 1/4	2	88N	12W
SW COR. NW 1/4 SE 1/4	2	88N	12W
NW COR. SW 1/4 SE 1/4	2	88N	12W