

Michael R. Fagle, P.L.S.

AECOM, 501 Sycamore St., Suite 222, Waterloo, Iowa 50703

1-319-232-6531

# UNITED STATES PUBLIC LAND SURVEY CORNER CERTIFICATE OF


Land Survey Monuments situated in Section 2, Township 88 North,  
Range 12 West, of the Fifth Principal Meridian, Black Hawk  
County, Iowa. Previously recorded in NO PREVIOUS TIES  
in County Recorder's Office. (Book, Page, Document Number, etc.)

(Show reason for preparing this certificate, the evidence and detailed procedures used in establishing the corner positions and monumentation found or placed.)

Monument Description and Remarks: Found 4" X 4" SCM/Brass Cap 12" deep.  
Set 1/2" rebar on the North side of the monument.

## PLAN - VIEW

(Show a minimum of three reference ties to durable physical objects, relevant monuments and physical conditions that will enable recovery of the corner.)

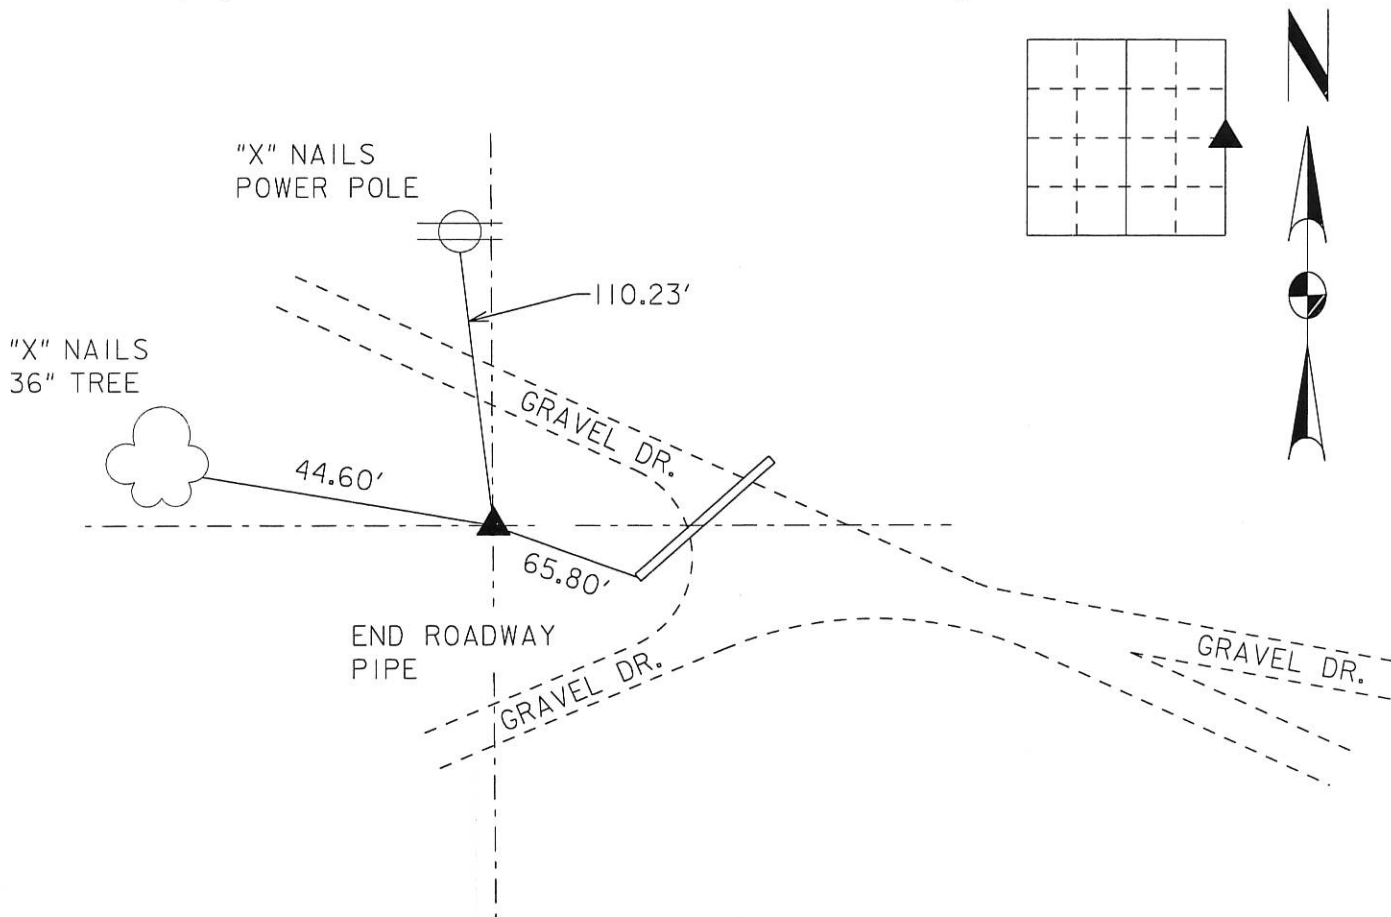

I hereby certify that this Land Surveying document was prepared by me or under my direct personal supervision and that I am a duly Licensed Land Surveyor under the laws of the State of Iowa.  
Michael R. Fagle 2-15-2017  
MICHAEL R. FAGLE Date  
License number 8505  
My license renewal date is December 31, 2018  
Pages or sheets covered by this seal:  
THIS SHEET

List Corners to be Indexed			
Corners	Section	Twp	Range
East Corner	2	T 88 N	R 12 W
West Corner	1	T 88 N	R 12 W