
Doc ID: 004190330001 Type: GEN Kind: CORNER RING: CORNER
Recorded: 07/06/2010 at 10:51:46 AM
Fee Amt: \$9.00 Page 1 of 1
Black Hawk County Iowa
JUDITH A MCCARTHY RECORDER

File 2011-00000229

Jeffrey P. Helland, 1107 Technology Parkway, Cedar Falls, Iowa 50613-6951, (319)-266-0161

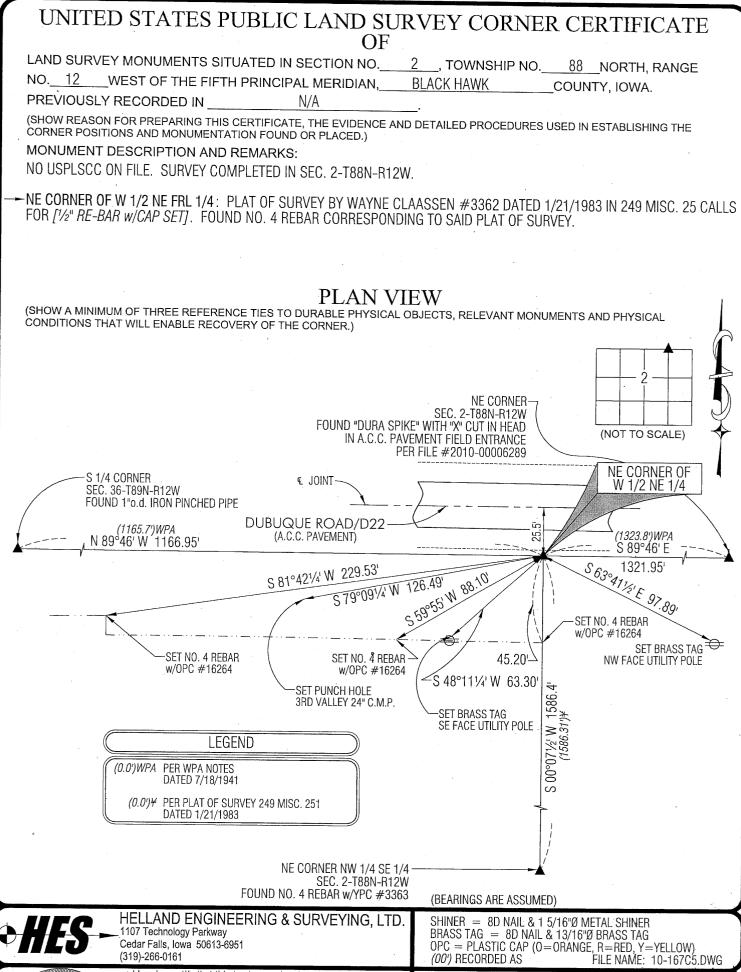

LAND JEFFREY P HELLAND 16264

4 W 0 \

I hereby certify that this land surveying document was prepared and the related survey work was performed by me or under my direct personal supervision and that I am a duly licensed Land Surveyor under the laws of the State of lowa.

Jeffrey P. Helland License Number 16264 My license renewal date is December 31, 2011. All pages or sheets are covered by this seal except: Wellund 6/30/10

LIST CORNERS TO BE INDEXED		
SECTION	TOWNSHIP	RANGE
· 2	88N	-12W
2	88N	12W
	ECTION 2	section township 2 88N