



PREPARED BY: BLACK HAWK COUNTY ENGINEERS OFFICE  
316 E. FIFTH STREET, ROOM 211 WATERLOO, IOWA 50703  
PH.# (319) 833-3008 SLSI 9-94  
FAX# (319) 833-3139 CERT 03-09

UNITED STATES PUBLIC LAND SURVEY CORNER CERTIFICATE OF  
Land Survey Monuments situated in Section 02, Township 88 N,  
Range 12 W, of the Fifth Principal Meridian, BLACK HAWK County, Iowa.  
Previously recorded in Fee Book N/A, Page N/A, in County Recorder's Office.  
(Show reason for preparing this certificate): The corner monument has been Replaced or Modified, per Ia. Code 355.11(1)(c)  
(Evidence and detailed procedures used in establishing the corner position(s) and monumentation found or placed.)  
Monument Description and Remarks: N.E. COR. LAND CORNER FOUND DESTROYED  
FROM COUNTY SUBDRAIN PROJECT IN 2008, WITH NO CURRENT CERTIFICATE ON RECORD.  
PLAT OF SURVEY PER MISC. 249 p.251 Dtd. JAN. 1983 UTILIZED FOR RE-ESTABLISHMENT.  
IN ADDITION TO PLS #16264 RECORD TIE TO S.E. COR. SECT. 36-T89-R12 HELD FROM EAST.  
PLATED DISTANCE FROM FOUND CORNER SOUTH, AND RECORD REF. TIE TO SAID S.E. CORNER  
"HELD" TO RE-ESTABLISH CORNER. 1955 IA. DOT PAVING PLANS "NO. 1049(1)" CALLS FOR  
CORNER 12.65' RT. (S.) OF C.L. ROAD GEOM. RESET 5"L. DURA™ SPIKE (w/RED X IN HEAD)  
w/ WASHER @ EAST SIDE OF SOUTH FIELD ENTR. IN ACC PAVING FILLET, & LOCATED ± 12"  
SOUTH OF "EXTENDED" SOUTH EDGE ACC/HMA PAVEMENT. CORNER UPDATED DUE TO ACC/  
HMA RESURF. PROJECT (MILLED 2" EXIST. 5" ACC OVERLAY & ADDED 5" H.M.A. OVERLAY

NOTE: ALL DISTANCES PLUMB/HORIZ.  
(H.D.), "UNLESS DENOTED".  
PLAN VIEW  
"NOT TO SCALE"  
BHco Hist. Ties: BK. #1001 p.02 88-12  
FIELD BOOK: Topsurv 7i: DbqRd-NE028812  
(Show a minimum of three reference ties to durable physical objects, relevant monuments and physical conditions  
that will enable recovery of the corner.)

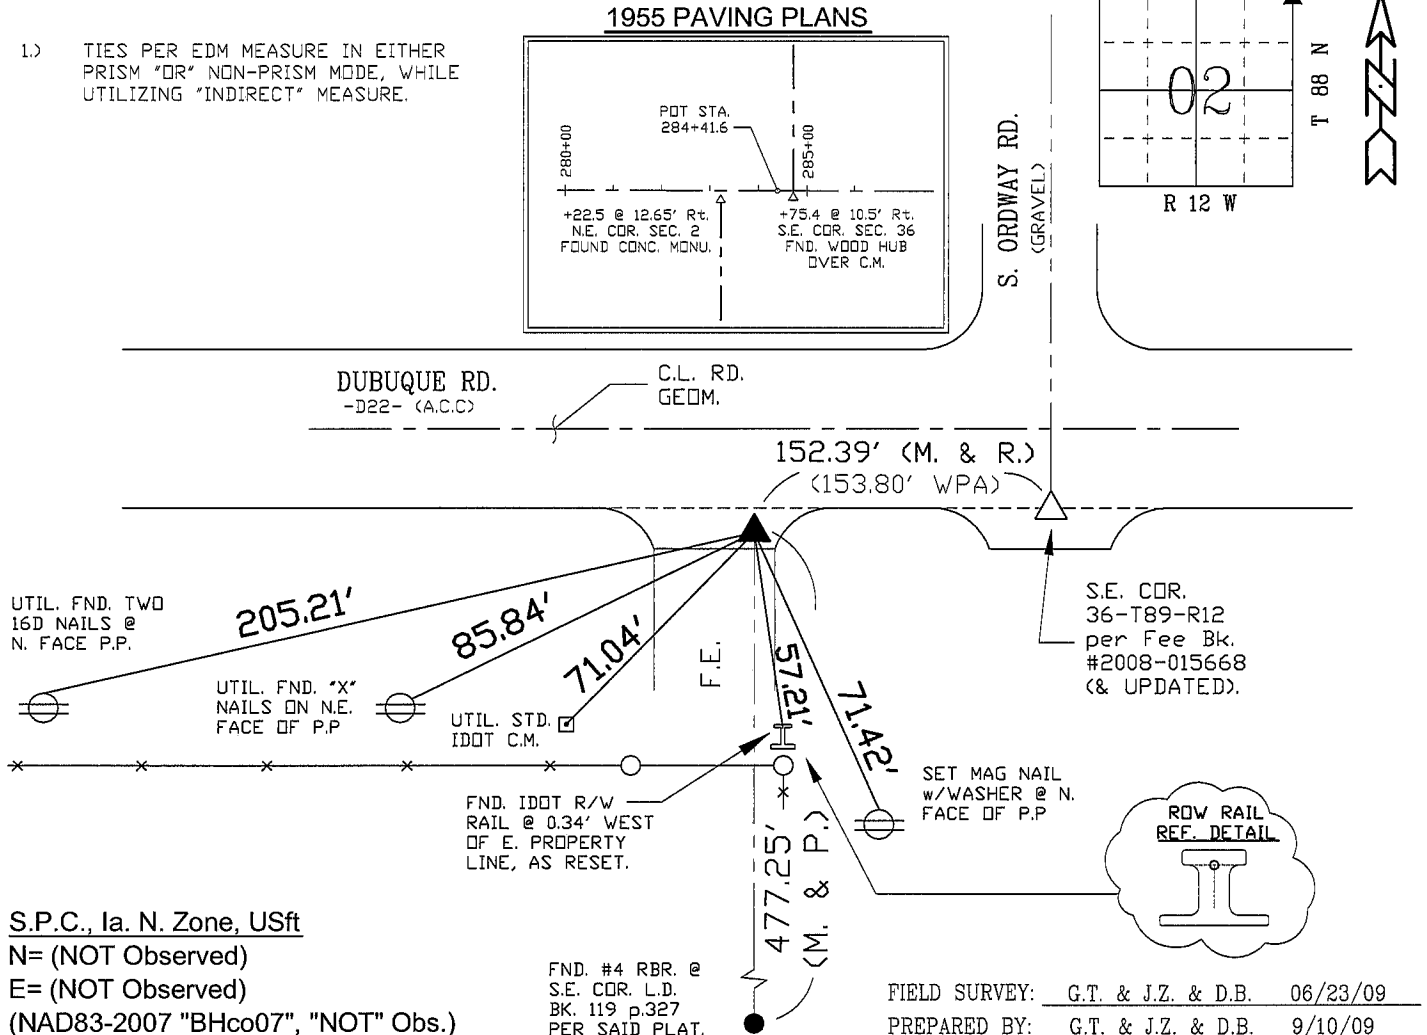

CERTIFICATION

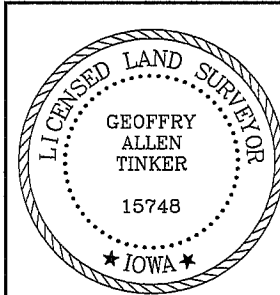

I hereby certify that this land surveying document was prepared and the related survey work was performed by me or under my direct personal supervision and that I am a duly licensed Land Surveyor under the laws of the State of Iowa.

*Geoffrey Allen Tinker* 09/23/2009  
Geoffrey Allen Tinker (date)

License Number 15748

My license renewal date is December 31, 2010

Pages or sheets covered by this seal:  
This Land Corner Certificate Only.

LIST CORNERS TO BE INDEXED

Corner	Section -	Township -	Range
N.E. Cor.	02	88 N	12 W
N.W. Cor.	01	88 N	12 W

INDEX OF ABBREVIATIONS

(M) = "Measured" Dimension  
(P) = "Platted" Dimension  
(R) = "Record" Dimension  
(C) = "Calculated" Dimension  
"IGS" = Iowa Geodetic Survey  
"WPA" = Works Progress Admin. Survey  
"G" = per George Miller Survey (BHco Surveyor 1858-1860)  
"B" = per John Ball Survey (BHco Surveyor 1868-1891)  
"N" = per Nathan Barber Survey (BHco Surveyor 1908-1931)  
"NP" = Reflectorless EDM Meas.  
"MLM" = Indirect Measure  
"CM" = Concrete Monument  
"SM" = Survey Marker Spike/Tag