

Recorded

UNITED STATES PUBLIC LAND SURVEY CORNER CERTIFICATE

OF


Land Survey Monuments situated in Section 3, Township 88 N, Range 12 W, of the Fifth Principal Meridian, BLACK HAWK County, Iowa.
Previously recorded in Book (NONE), Page .

Now reason for preparing this certificate, the evidence and detailed procedures used in establishing the corner positions and monumentation found or placed.)

Monument Description and Remarks: NO PREVIOUS CERTIFICATE.
FOUND EXISTING MONUMENT, SET 3/4" IRON PIPE OVER.
USED 4 UPDATED TIES PLACED BY W. ROBINSON IN 6-19-51
& UPDATED BY HIM IN 7-81. PURPOSE OF FILING THIS CERTIF.
IS TO SHOW THAT TRUE CORNER IS NOT THE ALUM. I.D.O.T. MONUMENT
LOCATED 26' S.

PLAN - VIEW


(Show a minimum of three reference ties to durable physical objects, relevant monuments and physical conditions that will enable recovery of the corner.)

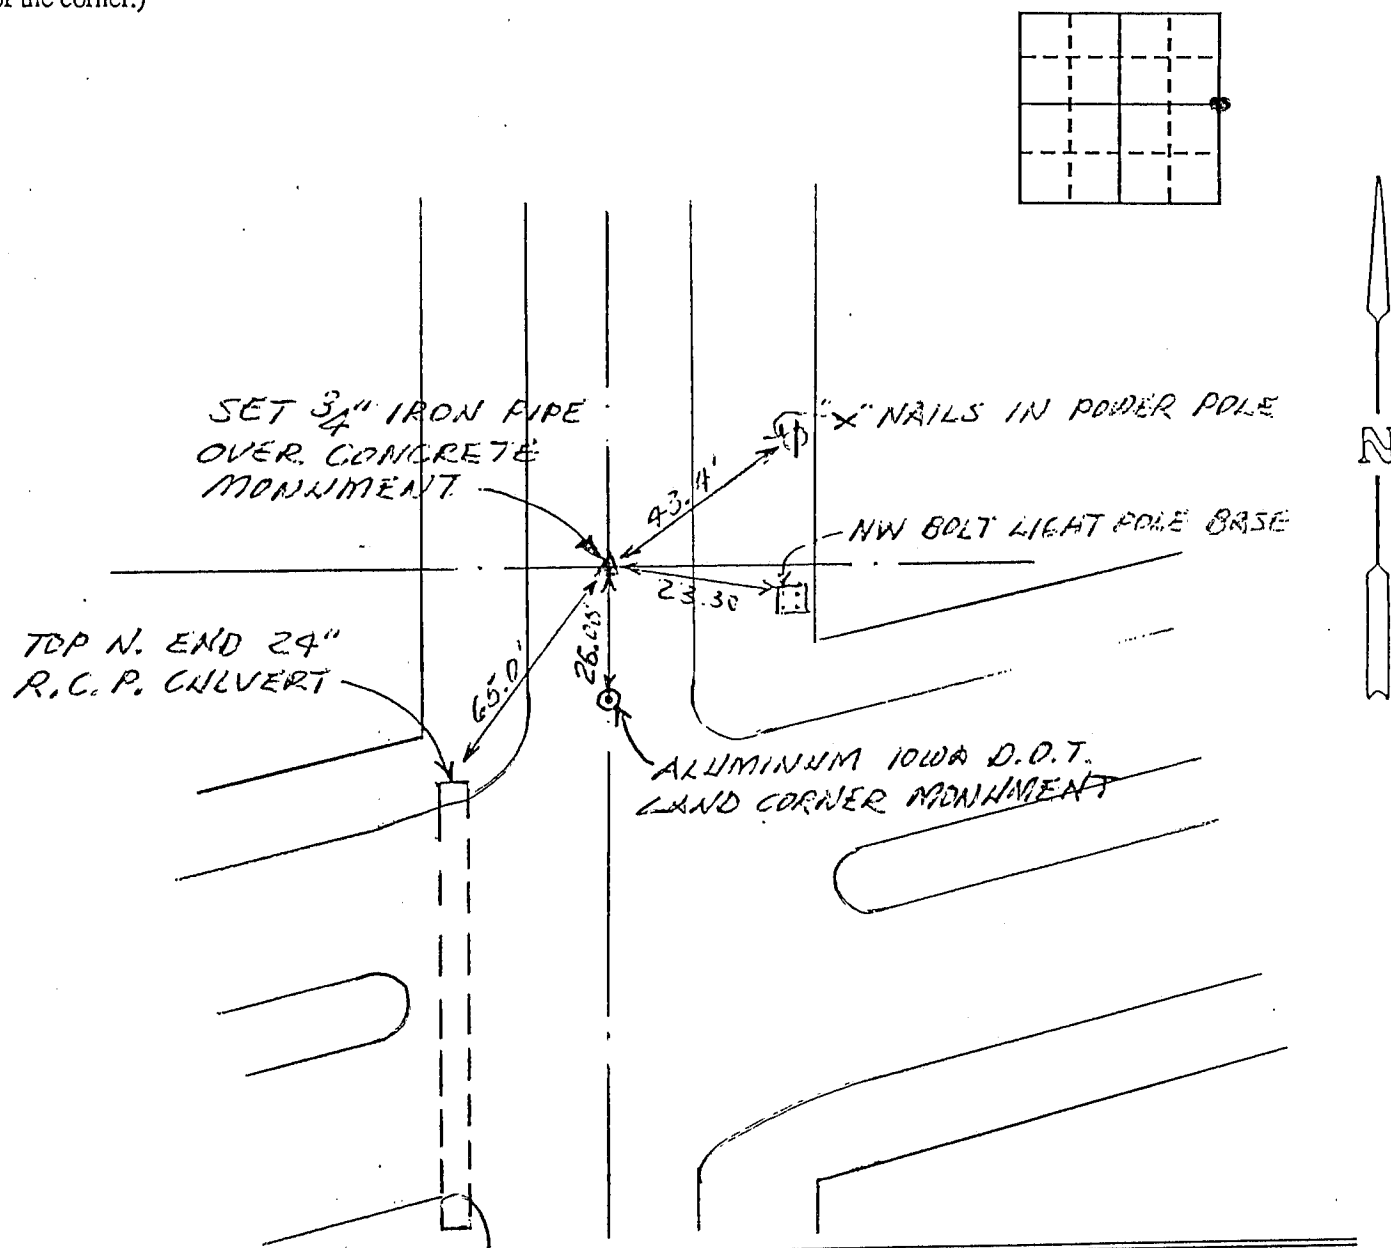

I hereby certify that the survey work was completed and this certificate was prepared by me or under my direct personal supervision and that I am a duly registered land surveyor under the laws of the state of Iowa.

Date
10/11/90

REGISTERED LAND SURVEYOR NO. 3862

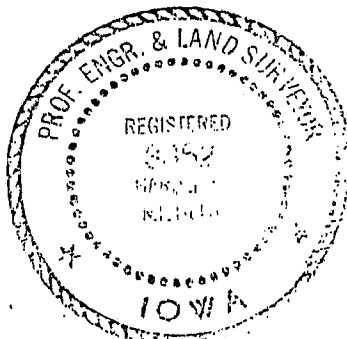

List Corners to be Indexed

Corners	Section	Twp	Range
E 4 COR.	3	88	12