

REC FEE 5.00
E FEE 2.00
TRAN FEE _____
REV FEE _____
GF _____
gm



Doc ID: 005596820001 Type: GEN
Recorded: 10/14/2014 at 09:11:43 AM
Fee Amt: \$7.00 Page 1 of 1
Black Hawk County Iowa
JUDITH A MCCARTHY RECORDER

File **2015-00006439**

anv WAYNE CLAASSEN ENGINEERING AND SURVEYING, INC.
P.O. BOX 898 WATERLOO, IOWA 50704-0898

PHONE: (VOICE) 319-235-6294
(FAX) 319-235-0028

UNITED STATES PUBLIC LAND SURVEY CORNER CERTIFICATE

Land Survey Monuments situated in Section 04, Township 88 North, Range 12 West, of the Fifth Principal Meridian, Black Hawk County, Iowa.

Previously recorded in _____ in County Recorder's Office.
(book, page, document number, etc.)


Monument Description and Remarks

The following are from WPA field notes (dated July 28, 1941) found in Black Hawk County Engineer's Office: "Found nothing, established corner on fence South, on North side of Corner post & on 1/4 fe from West. Reran Sub-division survey of Sec 4 & found Interior Stones which check location of point Establishment, Used Right line over interior Stones Sec. 4. S.C.M. flus & 0.8' So. of Cor post. Found niggerhead 12x8x6x 13.8' So of Cor. post on fe. So. (took this as no good) although proration of Original Gov. Survey on E side Sec. 4-88-12, indicates it should be 25.0' South of 1/4 fence. this Section Sub-divided by John Ball." Claassen Engineering found S.C.M. on Nov. 08, 1991 and tied out. Found S.C.M. 12" deep next to steel post. This certificate was filed because there is no certificate on file.

PLAN - VIEW

DUBUQUE RD.

Town & Country
Home Improvement

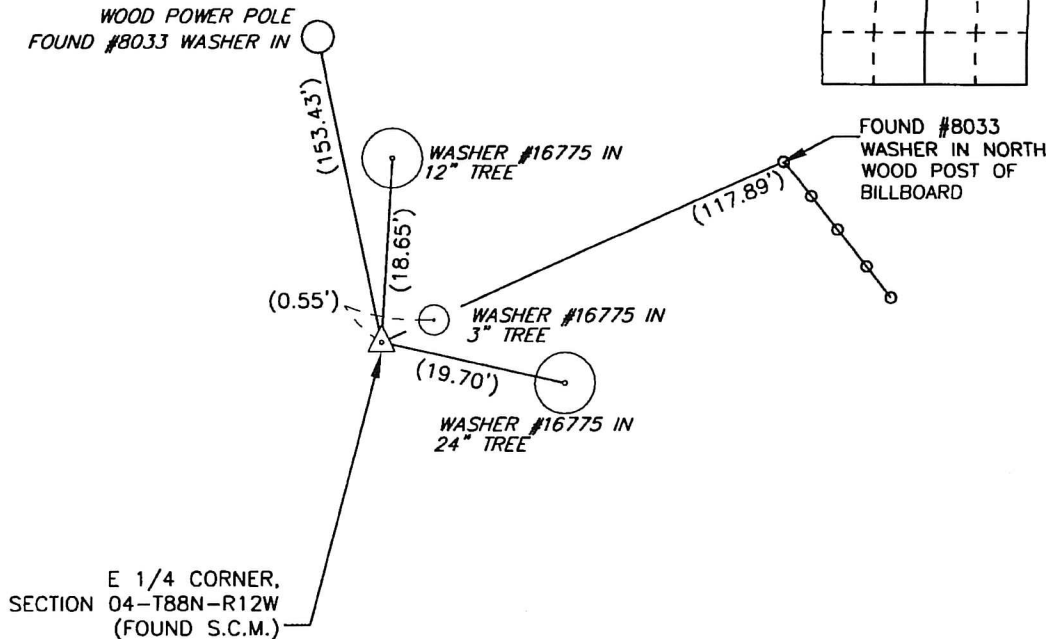

693-65

I hereby certify that this land surveying document was prepared and the related survey work was performed by me or under my direct personal supervision and that I am a duly Licensed Land Surveyor under the laws of the State of Iowa.

Signature: David L. Scheil
David L. Scheil, L.S.

Date: OCT 10, 2014 Lic. No. 16775

Pages or Sheets Covered by this Seal: THIS SHEET ONLY.

My license renewal date is December 31, 2014

SEAL

List Corners to be Indexed

Corners	Section	Twp	Range
E 1/4 CORNER,	04	88 N	12 W
W 1/4 CORNER,	03	88 N	12 W

