

SC
MISC
INDEX
MARGIN
PROOF
COMPARE

BLACK HAWK COUNTY IOWA:SS
Filed for record MAR 2, 2001 at
4:00 P.M. and recorded in Book 342
of MISC at Page 1

RECORDER

FEE 1-5.00/

AMENT INC 5825 DRY CREEK LN NE
PO BOX 10047 CEDAR RAPIDS IA 52410

PREPARED BY: GREGG E. SAMPSON, AMENT, INC., 5825 DRY CREEK LANE NE, CEDAR RAPIDS, IA (319) 378-1401

UNITED STATES PUBLIC LAND SURVEY CORNER CERTIFICATE
OF






Land Survey Monuments situated in Section 5 Township 88 NORTH Range
12 WEST of the Fifth Principal Meridian BLACK HAWK County, Iowa.

Previously recorded in N/A in County Recorder's Office.

Monument Description and Remarks: 1) FOUND P.K. NAIL NEAR CENTERLINE McCOY ROAD - POSITION AGREES

WITH PREVIOUS PLATTED DIMENSIONS 2) FOUND 1" PINCHED PIPE - MONUMENT AGREES WITH RECORD DIMENSIONS ON PLAT

OF WILSHIRE HEIGHTS IN ELK RUN HEIGHTS. 3) FOUND STANDARD CONCRETE MONUMENT STAMPED "33/5".

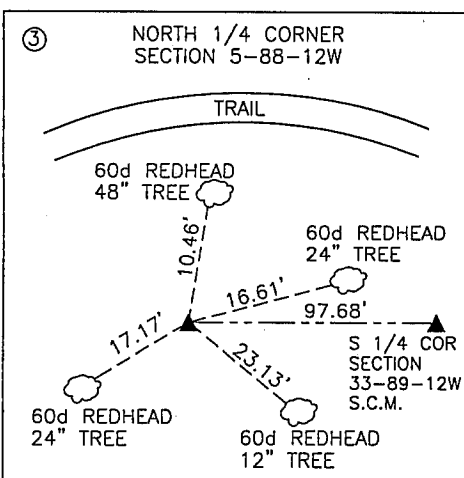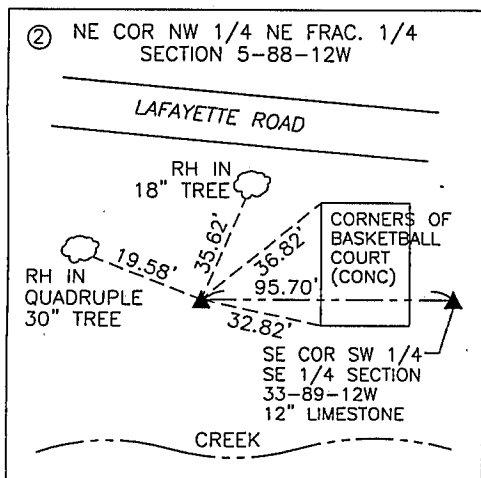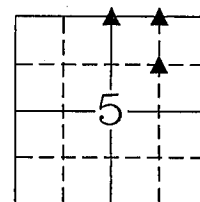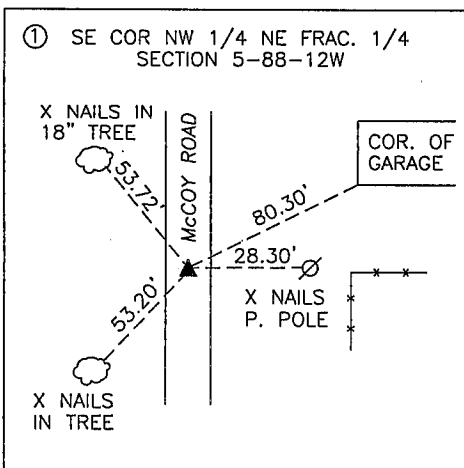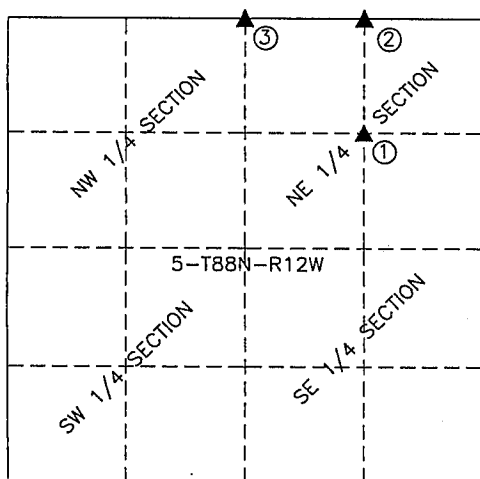


LEGEND

- FENCE
Ø POWER POLE
▲ SECTION CORNER

I hereby certify that the survey work was completed and this certificate was prepared by me or under my direct personal supervision and that I am a duly licensed land surveyor under the laws of the state of Iowa.

Signature: Gregg E. Sampson, Iowa Licensed Land Surveyor No. 14809

Date: 2-23-2001 License No. 14809
License renewal December 31, 2002

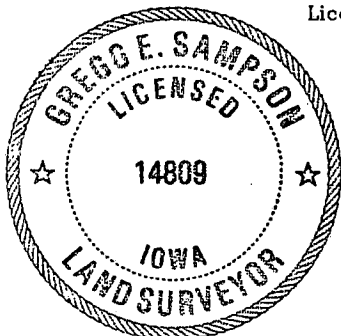

Land Corners to be Indexed			
Corners	Section	Twp	Range
① SE COR NW 1/4 NE FRAC 1/4	5	88N	12W
② NE COR NW 1/4 NE FRAC 1/4	5	88N	12W
③ N 1/4 COR	5	88N	12W

BOOK 0342 PAGE 001