

## UNITED STATES PUBLIC LAND SURVEY CORNER CERTIFICATE

OF


Land Survey Monuments situated in Section 7, Township 88, Range 12, of the Fifth Principal Meridian, BLACK HAWK County, Iowa.  
 Previously recorded in (not applicable) in County Recorder's Office.  
 (book, page, document number, etc.)

(Show reason for preparing this certificate, the evidence and detailed procedures used in establishing the corner positions and monumentation found or placed.)

Monument Description and Remarks: E 1/4 CORNER FOUND CONCRETE MONUMENT  
W/ BRASS CAP, RETIED. SE CORNER FOUND #4 BAR W/  
CAP (UNREADABLE), RETIED.

## PLAN - VIEW

(Show a minimum of three reference ties to durable physical objects, relevant monuments and physical conditions that will enable recovery of the corner.)

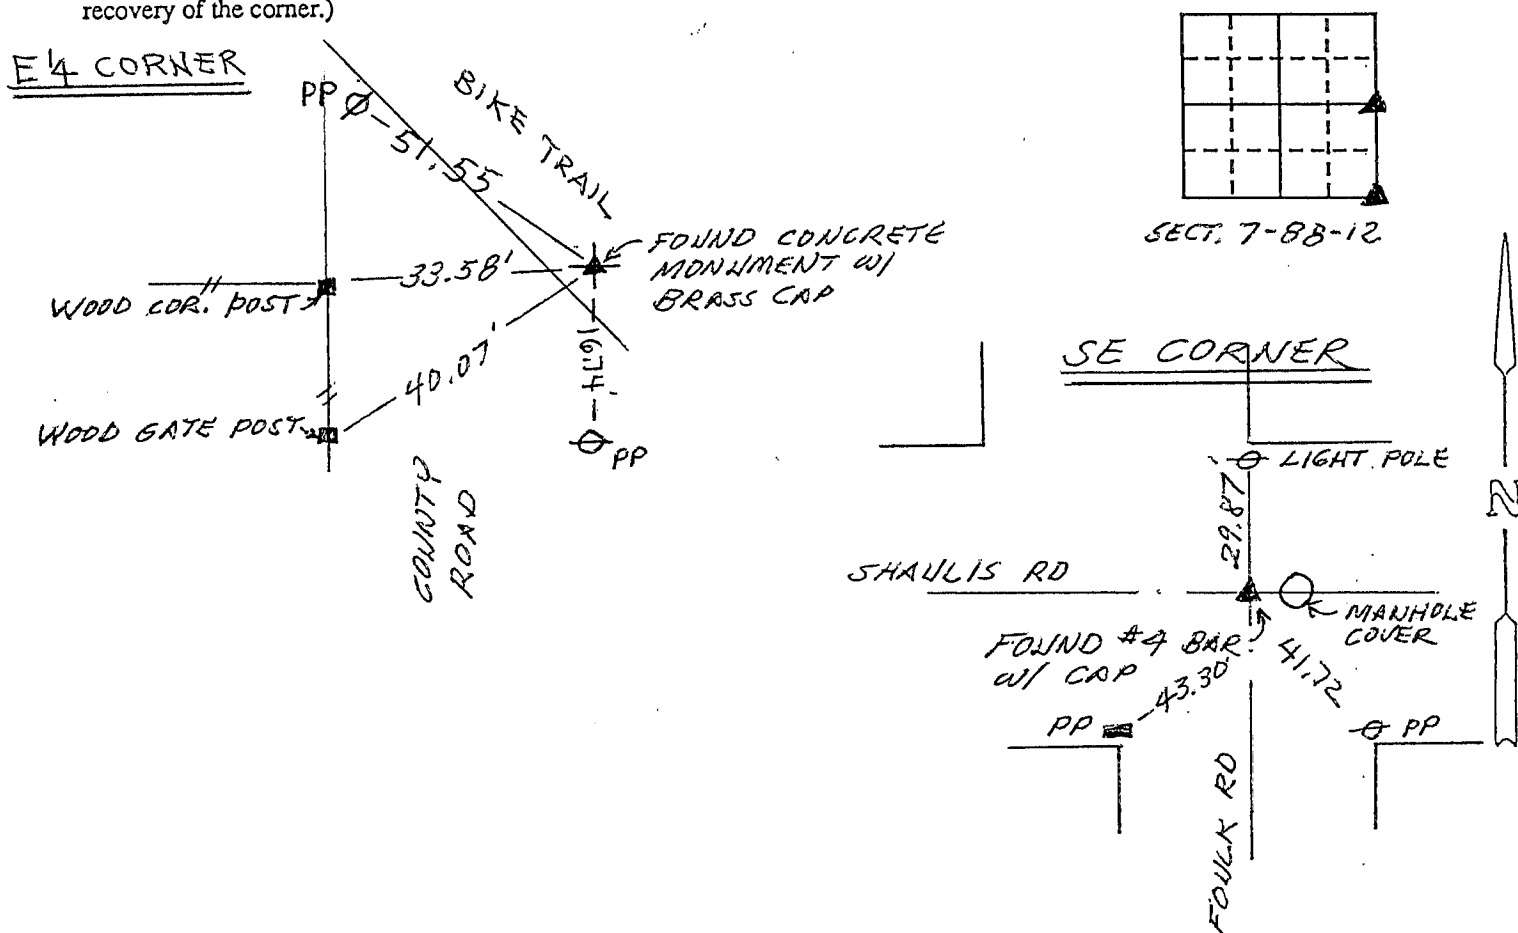

I hereby certify that the survey work was completed and this certificate was prepared by me or under my direct personal supervision and that I am a duly registered land surveyor under the laws of the state of Iowa.

Signature: Harold F. Michels

Name typed or printed: Harold F. Michels

Date: MAY 13, 1991 Reg. No. 3862

Corners	List Corners to be Indexed		
	Section	Twp	Range
E 1/4 COR.	7	88	12
W 1/4 COR.	8	88	12
SE COR.	7	88	12
NE COR.	18	88	12

SEAL



MISC. BK. 296 p. 48