

INDEX
PROOF

BLACK HAWK COUNTY, IOWA:SS

FEE BOOK # 2003 04150

FILED FOR RECORD AUG 13 2002 AT 10:30 A.M. FEE 1-5.00X

COMPARED

Harold F. Michels

BLACK HAWK COUNTY RECORDER

HAROLD MICHELS 410 BRENTWOOD AVE WATERLOO, IA 50701

Harold F. Michels 410 Brentwood Ave., Waterloo, Iowa 50701 319-235-7770

UNITED STATES PUBLIC LAND SURVEY CORNER CERTIFICATE

Land Survey Monuments situated in Section 10, Township 88 North, Range 12 West, of the Fifth Principal Meridian, BLACK HAWK County, Iowa.
Previously recorded in N/A in County Recorder's Office.
(book, page, document number, etc.)


(Show reason for preparing this certificate, the evidence and detailed procedures used in establishing the corner positions and monumentation found or placed.)

Monument Description and Remarks FOUND SPIKE OVER CONCRETE MONUMENT.
Set new ties.

PLAN - VIEW

(Show a minimum of three reference ties to durable physical objects, relevant monuments and physical conditions that will enable recovery of the corner.)

N4 CORNER

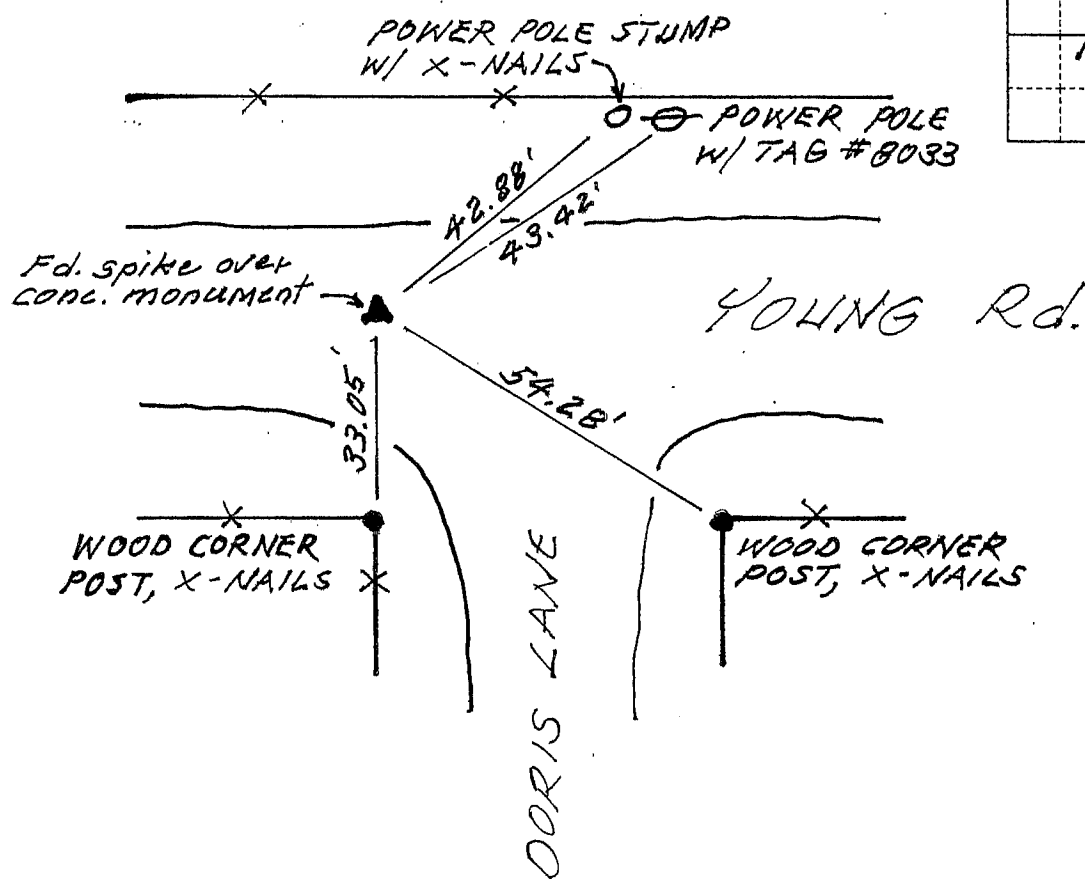

I hereby certify that the survey work was completed and this certificate was prepared by me or under my direct personal supervision and that I am a duly registered land surveyor under the laws of the state of Iowa.

Signature: Harold F. Michels

Harold F. Michels

Date: 8-8-02

Reg. No. 3862

My registration renewal date is Dec. 31, 2003.

SEAL

List Corners to be Indexed

Corners	Section	Twp	Range
<u>N4 COR.</u>	<u>10</u>	<u>88</u>	<u>12</u>

