

I VS  
P  
Z

Document Number: 2007009185

Date: Oct 20, 2006 4:30:00 pm

Aud Fee: 0.00 Rec Fee: 5.00

Trans Tax: 0.00 Rec Management Fee: 1.00

E-Com Fee: 1.00 Non-Standard Page Fee: 0.00

Filed for record in Black Hawk County, Iowa


Patricia S. Sass, County Recorder

Kirk D. Eschliman, P.L.S. Iowa Lic. No. 9961, 723 Broadway Street, Waterloo, Iowa 50703 - Phone: 319-234-0509

UNITED STATES PUBLIC LAND SURVEY CORNER CERTIFICATE  
OFLAND SURVEY MONUMENTS SITUATED IN SECTION EIGHTEEN (18), TOWNSHIP EIGHTY-EIGHT (88 NORTH)  
RANGE TWELVE (12) WEST, OF THE FIFTH PRINCIPAL MERIDIAN, BLACK HAWK COUNTY, IOWA.  
PREVIOUSLY RECORDED IN MISC. 331 041 (BOOK, PAGE, DOCUMENT NUMBER, ETC.) IN THE COUNTY RECORDER'S OFFICE.


(SHOW REASON FOR PREPARING THIS CERTIFICATE, THE EVIDENCE AND DETAILED PROCEDURES USED IN ESTABLISHING THE CORNER POSITIONS AND MONUMENTATION FOUND OR PLACED.)

## MONUMENT DESCRIPTION AND REMARKS:

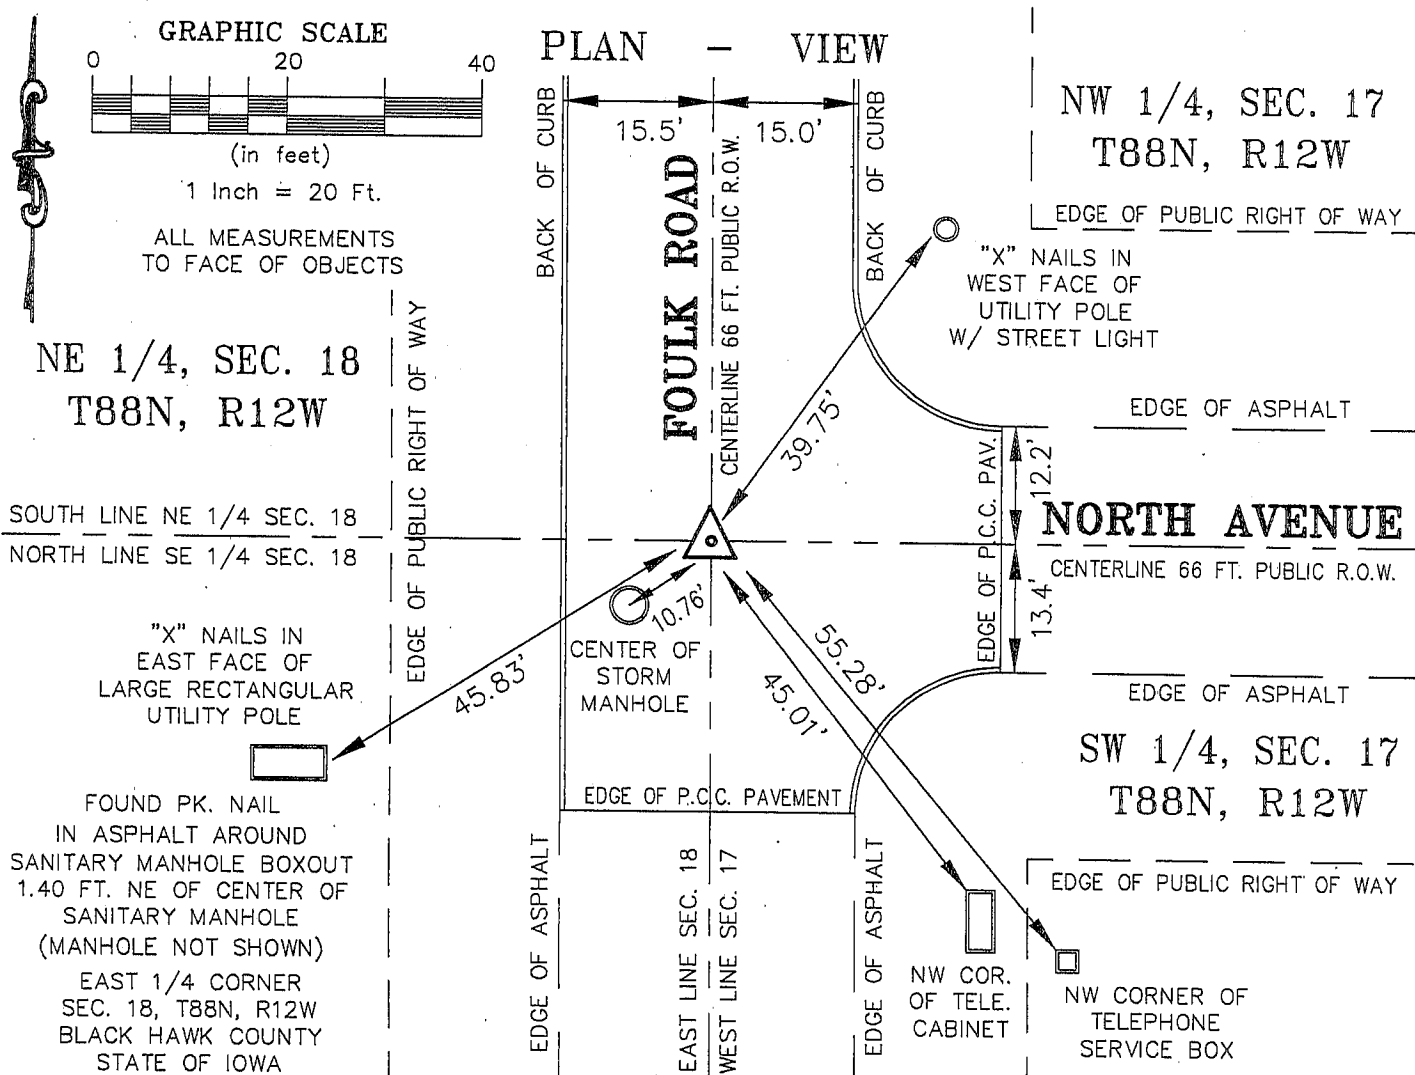MONUMENT RETIED AS A CORRECTION TO MISCELLANEOUS BOOK 331 PAGE 41 IN THE BLACK HAWK COUNTY  
RECORDER'S OFFICE. FOUND PK. NAIL IN ASPHALT AROUND SANITARY MANHOLE BOXOUT IN  
FOULK ROAD P.C.C. PAVEMENT. MONUMENT USED IN REFERENCED FIELD SURVEY IN NE 1/4 SECTION 18.I HEREBY CERTIFY THAT THIS LAND SURVEYING DOCUMENT  
WAS PREPARED AND RELATED SURVEY WORK WAS  
PERFORMED BY ME OR UNDER MY DIRECT PERSONAL  
SUPERVISION AND THAT I AM A DULY LICENSED LAND  
SURVEYOR UNDER THE LAWS OF THE STATE OF IOWA.Kirk D. Eschliman  
DATE: 10/13/2006KIRK D. ESCHLIMAN, P.L.S. IOWA LIC. NO. 9961  
MY LICENSE RENEWAL DATE IS DECEMBER 31, 2007  
PAGES OR SHEETS COVERED BY THIS SIGNATURE & SEAL: SHEET 1 OF 1FOR: CITY OF WATERLOO  
LLOYD RANDALL PARK  
WATERLOO, IOWA 50702REQ. BY: NOEL ANDERSON  
CITY OF WATERLOO PLANNERKESS & ASSOCIATES, INC.  
PROFESSIONAL LAND SURVEYORS : 723 BROADWAY, WATERLOO, IOWA 50703-5811  
DATE: 10/13/2006 C.A.D.D. FILE: 06B83SCC1.DWG PROJECT NO.: 06B83

## List of corners to be indexed:

Corner	Section	Township	Range
E 1/4	18	T88N	R12W

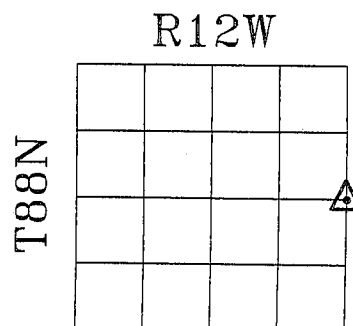

SECTION 18