

SC  
MISC  
INDEX  
MARGIN  
PROOF  
COMPARE

*William L. King* Recorder  
FEE 1- 5.00/  
WAYNE CLAASSEN ENGINEERING AND SURVEYING, INC.

WAYNE CLAASSEN ENGINEERING AND SURVEYING, INC.  
P.O. BOX 898 WATERLOO, IOWA 50704-0898

PHONE: (VOICE) 319-235-6294  
(FAX) 319-235-0028

# UNITED STATES PUBLIC LAND SURVEY CORNER CERTIFICATE


Land Survey Monuments situated in Section 20, Township 88N, Range 12W, of the Fifth Principal Meridian, BLACK HAWK County, Iowa.  
Previously recorded in N/A in County Recorder's Office.  
(book, page, document number, etc.)

(Show reason for preparing this certificate, the evidence and detailed procedures used in establishing the corner positions and monumentation found or placed.)

Monument Description and Remarks N 1/4 CORNER ~ FOUND SCRA 18" DEEP PER  
WIPA NOTES. SET 1/2" REBAR ON NORTH SIDE 1" BELOW TOP. CORNER  
IS IN CULTIVATED FIELD ~ NO SIGN SET.


## PLAN - VIEW

(Show a minimum of three reference ties to durable physical objects, relevant monuments and physical conditions that will enable recovery of the corner.)

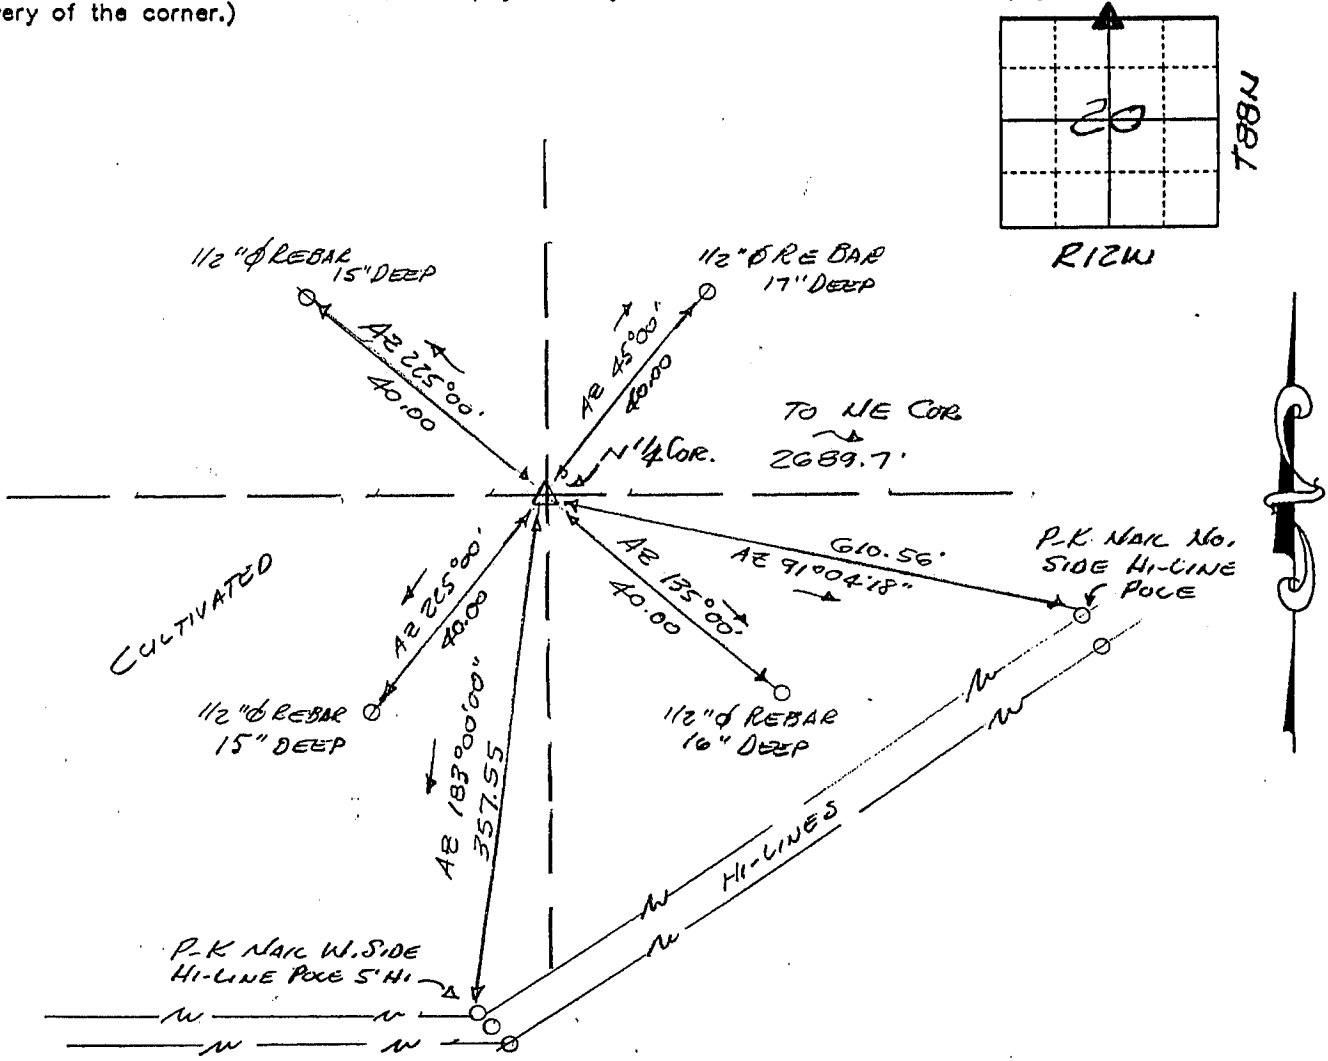

I hereby certify that the survey work was completed and this certificate was prepared by me or under my direct personal supervision and that I am a duly licensed land surveyor under the laws of the state of Iowa.

Signature: *F. William L. King*  
(Name typed or printed:) F. WILLIAM KING  
Date: DEC. 10, 1998 Lic. No. 8033

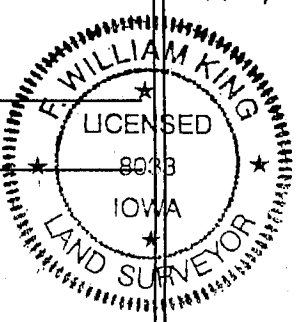

List Corners to be Indexed			
Corners	Section	Twp	Range
N 1/4	20	88N	12W

SEAL