

SC
MISC
INDEX
MARGIN
PROOF
COMPARE

BLACK HAWK COUNTY IOWA:SS
Filed for record Dec 11, 19 98 at
11:30 A.M. and recorded in Book 332
of MISC Page 551
Recorder
FEE 1-5.00/
WAYNE CLAASSEN ENGINEERING AND SURVEYING, INC.

WAYNE CLAASSEN ENGINEERING AND SURVEYING, INC.
P.O. BOX 898 WATERLOO, IOWA 50704-0898

PHONE: (VOICE) 319-235-6294
(FAX) 319-235-0028

UNITED STATES PUBLIC LAND SURVEY CORNER CERTIFICATE


and Survey Monuments situated in Section 20, Township 88N, Range 12W, of the Fifth Principal Meridian, BLACK HAWK County, Iowa.
Previously recorded in N/A in County Recorder's Office.
(book, page, document number, etc.)

Show reason for preparing this certificate, the evidence and detailed procedures used in establishing the corner positions and monumentation found or placed.)

Monument Description and Remarks FOUND SCM WITH TOP 4"± BROKEN OFF PER
WPA NOTES. BASE OF MONUMENT WAS STILL VERTICAL. CUT "X" IN CENTER OF
BASE & SET BROKEN TOP BACK ON BASE. TOP IS FLUSH WITH GROUND. SET 1/2"Ø
REBAR ON NO. SIDE OF MONUMENT, 1" BELOW TOP. SET "SURVEY MARKER" SIGN
1' EAST OF CORNER. (NE CORNER.)

PLAN - VIEW

Show a minimum of three reference ties to durable physical objects, relevant monuments and physical conditions that will enable recovery of the corner.)

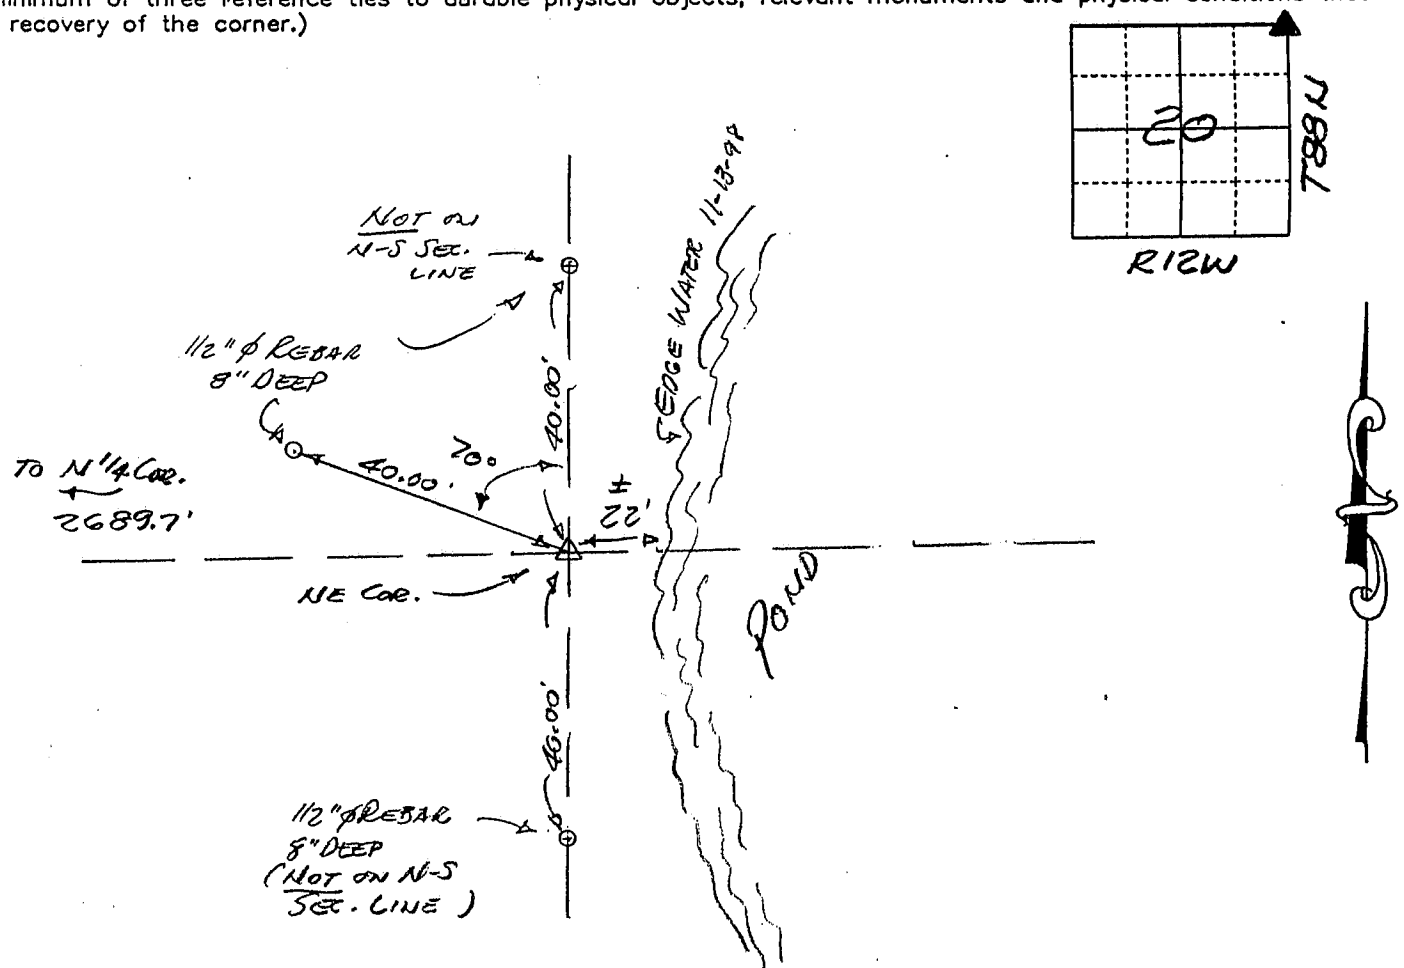

507-15

I hereby certify that the survey work was completed and this certificate was prepared by me or under my direct personal supervision and that I am a duly licensed land surveyor under the laws of the state of Iowa.

Signature: F. William King
(Name typed or printed:) F. William King
Date: DEC. 10, 1998 Lic. No. 8033

List Corners to be Indexed

Corners	Section	Twp	Range
<u>NE</u>	<u>20</u>	<u>88N</u>	<u>12W</u>

SEAL

BOOK **332** PAGE **551**

