

RECEIVED - BLACK HAWK CO. ASSESSOR

SC
MISC
INDEX
MARGIN
PROOF
COMPARE

BLACK HAWK COUNTY IOWA:SS
Filed for record OCT 13, 1999 at 8695
11:00 AM. and recorded in Book 336
of MISC Page 24

Scott A. Steinfeld Recorder
FEE 1-5.00

S & S LAND SURVEYING INC
PO BOX 148
WAVERLY IA 50677

PREPARED BY - S & S LAND SURVEYING, INC., 115 W BREMER AVE., PO BOX 148, WAVERLY, IOWA 50677 - PHONE 319-352-9444

UNITED STATES PUBLIC LAND SURVEY CORNER CERTIFICATE

OF


Land Survey Monuments situated in Section 21, Township 88, Range 12
of the Fifth Principal Meridian, BLACK HAWK County, Iowa.
Previously recorded in Book _____, Page _____.

MONUMENTS RECOVERED FOR SURVEY IN THE S.W. 1/4




PLAN-VIEW


NO SCALE

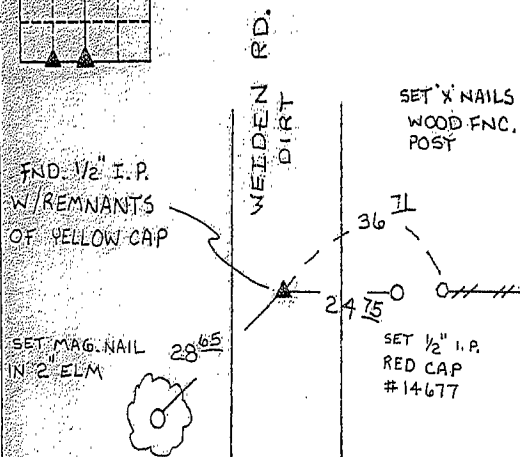


N.W. COR. NE SW 1/4

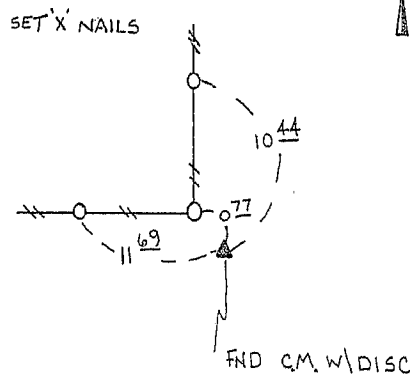

CENTER

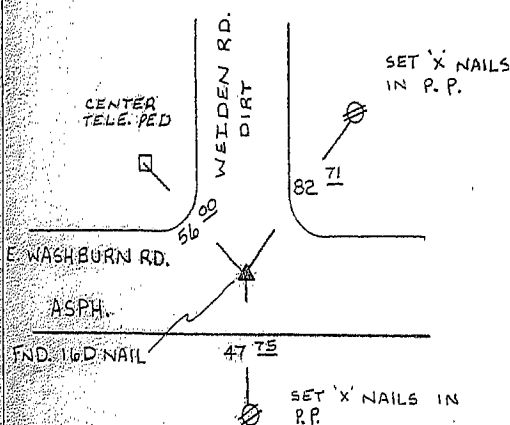

S.W. COR. SE SW 1/4

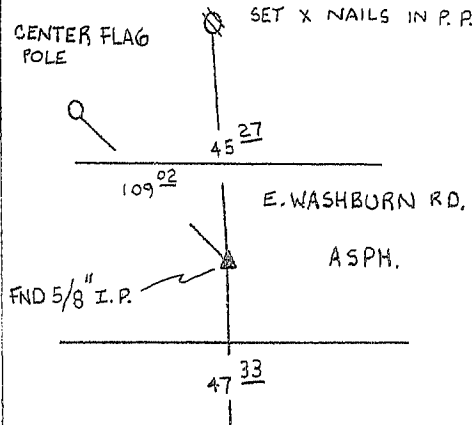

S 1/4 COR.

I hereby certify that this land surveying document was prepared and the related survey work was performed by me or under my direct personal supervision and that I am a duly Licensed Professional Land Surveyor under the laws of the State of Iowa.

Scott A. Steinfeld
Scott A. Steinfeld, P.L.S.
Iowa License No. 14677
My License Renewal Date is Dec. 31, 2000.

10/11/99
date

S & S
LAND SURVEYING, INC.

115 W. BREMER AVE., PO BOX 148
WAVERLY, IOWA 50677
(319) 352-9444

List Corners to be Indexed

Corners	Section	Twp	Range
NW, NE, SW	21	88	12
SW, SE, SW	"	"	"
CENTER	"	"	"
S 1/4	"	"	"

